


15-145-00523-0000

WELL PLUGGING RECORD

Give All Information Completely
Make Required Affidavit
Mail or Deliver Report to:
Conservation Division
State Corporation Commission
809 Fitting Building
Wichita, Kansas

NORTH

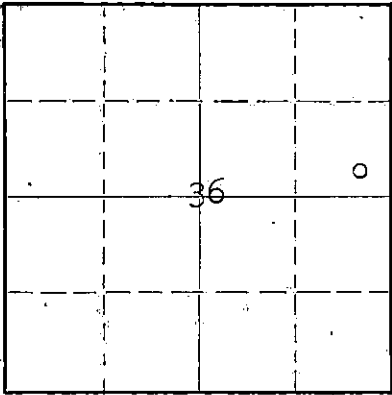

Locate well correctly on above Section Flat

Pawnee County. Sec. 36 Twp. 23 Rge. 16 (W) (W)
Location as "NE/CNW/4SW/4" or footage from lines SE/4 SE/4 NE/4
Lease Owner Dunne-Gardner Drilling Co., Inc.
Lease Name Peters Well No. 1
Office Address 300 Schweiter Building, Wichita, Kansas
Character of Well (completed as Oil, Gas or Dry Hole) Dry Hole
Date well completed January 4 19 59
Application for plugging filed January 4 19 59
Application for plugging approved January 4 19 59
Plugging commenced January 4 19 59
Plugging completed January 4 19 59
Reason for abandonment of well or producing formation Dry Hole
If a producing well is abandoned, date of last production 19
Was permission obtained from the Conservation Division or its agents before plugging was commenced? Yes

Name of Conservation Agent who supervised plugging of this well Frank Broadfoot
Producing formation Depth to top Bottom Total Depth of Well 3900 Feet
Show depth and thickness of all water, oil and gas formations.

OIL, GAS OR WATER RECORDS

CASING RECORD

Formation	Content	From	To	Size	Put In	Pulled Out
Surface Casing		0	245	8 5/8"		

Describe in detail the manner in which the well was plugged, indicating where the mud fluid was placed and the method or methods used in introducing it into the hole. If cement or other plugs were used, state the character of same and depth placed, from feet to feet for each plug set.

Fill hole with drilling - set plug @ 240' - 1/3 sack of hulls and 20 sacks cement - mud to 35' - plug and 1/3 sack of hulls and 10 sacks cement.

STAT. REGISTRATION ON
JAN 14
CONSERVATION DIVISION
Wichita

(If additional description is necessary, use BACK of this sheet)

1-14-59

Correspondence regarding this well should be addressed to Address

STATE OF Kansas, COUNTY OF Sedgwick, ss.
Don Gardner (employee of owner) or (owner or operator) of the above-described well, being first duly sworn on oath, says: That I have knowledge of the facts, statements, and matters herein contained and the log of the above-described well as filed and that the same are true and correct. So help me God.

(Signature) *Don Gardner*
300 Schweiter Bldg., Wichita, Kansas
(Address)

SUBSCRIBED AND SWORN to before me this 5th day of January, 19 59
Shelburn D. Barnett
Notary Public.

My commission expires 27 July 1960

PLUGGING
FILE SEC 36 T23 R16W
BOOK PAGE 17 LINE 33

DRILLER'S LOG

15-145-00523-0000

Company: Dunne-Gardner Drilling Co., Inc.
 300 Schweiter Building
 Wichita 2, Kansas

Lease: Peters

Well: No. 1

Location: SE SE NE of Section 36, Township 23 South,
 Range 16 West, Pawnee County, Kansas

Contractor: Dunne-Gardner Drilling Co., Inc.
 300 Schweiter Building
 Wichita 2, Kansas

Date Comm: December 23, 1958

Date Compl: January 4, 1959

T. D.: 3900 feet

Casing: 245' - 8 5/8" Surface Casing w/175
 sacks cement, 1% c.c.

<u>From</u>	<u>To</u>	
0	75	Sand
75	160	Shale
160	245	Shale - Shells
245	485	Shale - Red Bed
485	575	Sand - Shale
575	970	Red Bed - Shale - Shells
970	990	Anhydrite
990	1490	Shale-Shells
1490	1825	Shale - Lime
1825	2845	Lime - Shale
2845	3120	Shale - Lime
3120	3515	Lime - Shale
3515	3570	Lime
3570	3625	Lime - Shale
3625	3900	Lime
	3900	T. D.
	D.&A.	

RECEIVED
 STATE COMMISSION
 JAN 14 1959
 CONSERVATION DIVISION
 Wichita, Kansas

I certify the above to be true and correct to the best of my knowledge and belief.

DUNNE-GARDNER DRILLING CO., INC.

By Don Gardner
 Don Gardner

State of Kansas }
 County of Sedgwick } S.S.

Subscribed and sworn before me this 12th day of January, 1959.

My Commission Expires:

27 July 1960

William D. Bennett
 Notary Public

PLUGGING
 FILE SEC 36 T 23 R 16W
 BOOK PAGE 1 LINE 33