


STATE OF KANSAS
STATE CORPORATION COMMISSION

Give All Information Completely
Make Required Affidavit
Mail or Deliver Report to:
Conservation Division
State Corporation Commission
212 No. Market
Wichita, Kansas

WELL PLUGGING RECORD

Stafford County. Sec. 13 Twp. 21 Rge. (E) 12 (W)

Location as "NE/CNW/SW" or footage from lines
Lease Owner Clinton Oil Company
Lease Name Loretta E. Tindall Well No. 3-D
Office Address 217 No. Water, Wichita, Kansas 67202
Character of Well (completed as Oil, Gas or Dry Hole) Dry Hole
Date well completed October 11 19 69
Application for plugging filed October 14 19 69
Application for plugging approved October 14 19 69
Plugging commenced October 11 19 69
Plugging completed October 11 19 69
Reason for abandonment of well or producing formation Dry Hole

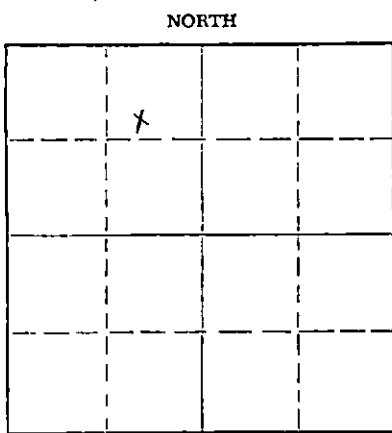

Locate well correctly on above Section Plat

If a producing well is abandoned, date of last production _____ 19____
Was permission obtained from the Conservation Division or its agents before plugging was commenced? yes

Name of Conservation Agent who supervised plugging of this well R. J. Warren, Box 322, Pratt, Kansas
Producing formation Lansing-Kansas City Depth to top 3187' Bottom 3424' Total Depth of Well 3550 Feet
Show depth and thickness of all water, oil and gas formations.

OIL, GAS OR WATER RECORDS

CASING RECORD

FORMATION	CONTENT	FROM	TO	SIZE	PUT IN	PULLED OUT
<u>Lansing-Kansas City</u>		<u>3187'</u>		<u>8 5/8"</u>	<u>320'</u>	<u>None</u>

Describe in detail the manner in which the well was plugged, indicating where the mud fluid was placed and the method or methods used in introducing it into the hole. If cement or other plugs were used, state the character of same and depth placed, from _____ feet to _____ feet for each plug set.
Filled hole w/heavy mud from 3550(RTD). Set plug at 450' w/50 sx cement.
Filled hole with heavy rotary mud. Set plug at 300' w/25 sx cement.
Filled hole with heavy rotary mud. Set plug at 40' w/10 sx cement.
Filled hole w/2 sx cement to rathole.

RECEIVED
STATE CORPORATION COMMISSION
NOV 6 1969
CONSERVATION DIVISION
Wichita, Kansas

(If additional description is necessary, use BACK of this sheet)
Name of Plugging Contractor Garvey Drilling Company
Address Rte# 2, Great Bend, Kansas 67530

STATE OF KANSAS, COUNTY OF SEDGWICK, ss.
Earl E. Rossman (employee of owner) or (owner/operator) of the above-described well, being first duly sworn on oath, says: That I have knowledge of the facts, statements, and matters herein contained and the log of the above-described well as filed and that the same are true and correct. So help me God.

(Signature) Earl E. Rossman
217 No. Water, Wichita, Kansas 67202
(Address)

DESCRIBED AND SWORN TO before me this 5th day of November, 19 69
Marcella L. Schepis
Notary Public.

My commission expires June 1973
MARCELLA L. SCHEPIS
NOTARY PUBLIC
SEDGWICK COUNTY

WELL LOG


COMPANY Clinton Oil Company
 FARM Loretta E. Tindall NO. 3-D
 TOTAL DEPTH 3550'
 COMM. 10- 3-69 COMP. 10-12-69
 CONTRACTOR Garvey Drilling Company

SEC. 13 T. 21S R. 12W

LOC. SW NE NW

COUNTY Stafford, Kansas

CASING
 8 5/8" @ 320' w/325sx

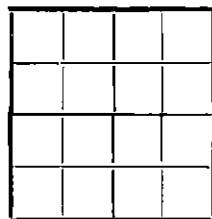

ELEVATION

PRODUCTION D & A

FIGURES INDICATE BOTTOM OF FORMATIONS

- 180' Sand
- 320' Red Bed & Shale
- 550' Red Rock
- 587' Shale & Shells
- 608' Anhydrite
- 875' Shale
- 1525' Shale & Lime
- 1720' Lime & Shale
- 2225' Shale & Lime
- 2700' Shale
- 2987' Lime & Shale
- 3228' Lime
- 3490' Lime & Shale
- 3512' Conglomerate & Chert
- 3550' Chert, Lime, & Shale
- 3550' RTD

RECEIVED
 STATE CORPORATION COMMISSION
 NOV 6 1969
 CONSERVATION DIVISION
 Wichita, Kansas

State of Kansas }
 County of Barton } ss

I, Charlene Marker of Garvey Drilling Company

upon oath state the above and foregoing is a true and correct copy of the Loretta E. Tindall No. 3-D well.

Charlene Marker

Subscribed and sworn to before me this 13th day of October 19 69

My Commission Expires: November 5, 1969

Richard St. Boy
 NOTARY PUBLIC