


STATE OF KANSAS  
STATE CORPORATION COMMISSION

WELL PLUGGING RECORD

Give All Information Completely  
Make Required Affidavit  
Mail or Deliver Report to  
Conservation Division  
State Corporation Comm.  
245 North Water  
Wichita, KS 67202

Stafford County, Sec. 13 Twp. 21S Rge. 14 WNW  
Location as "NE/CNW $\frac{1}{4}$ SW $\frac{1}{4}$ " or footage from lines  
SE/4 SW/4 NE/4  
Lease Owner American Energies Corp.  
Lease Name McGinty Well No. #1-13  
Office Address 575 Fourth Financial Center, Wichita, KS  
Character of Well (Completed as Oil, Gas or Dry Hole)  
dry hole  
Date Well completed 7/31 1981  
Application for plugging filed 7/31 1981  
Application for plugging approved 7/31 1981  
Plugging commenced 7/31 1981  
Plugging completed 7/31 1981  
Reason for abandonment of well or producing formation  
No commercial quantity of gas or oil encountered.  
If a producing well is abandoned, date of last production  
19  
Was permission obtained from the Conservation Division or  
its agents before plugging was commenced? Yes

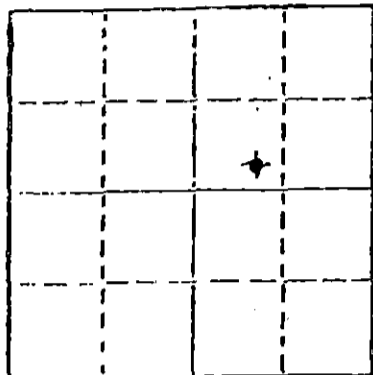

Locate well correctly on above  
Section Plot

Name of Conservation Agent who supervised plugging of this well Mr. Towman  
Producing formation Depth to top Bottom Total Depth of Well  
Show depth and thickness of all water, oil and gas formations.

OIL, GAS OR WATER RECORDS

CASING RECORD

FORMATION	CONTENT	FROM	TO	SIZE	PUT IN	PULLED OUT

Describe in detail the manner in which the well was plugged, indicating where the mud fluid was placed and the method or methods used in introducing it into the hold. If cement or other plugs were used, state the character of same and depth placed, from feet to feet for each plug-set.

Total Depth 3740'. Set first plug at 740 feet with 50 sacks cement, second plug at 275 feet with 30 sacks, 10 sacks at 40 feet and 10 sacks in rat hole. Cement by Sun Cementing. Job completed at 6:30 p.m. on July 31, 1981. State Pluggger - Mr. Towman

RECEIVED  
STATE CORPORATION COMMISSION

AUG 5 1981

(If additional description is necessary, use BACK of this sheet)  
Name of Plugging Contractor KAW Drilling Co., Inc. Conservation Division  
Wichita, Kansas

STATE OF KANSAS COUNTY OF SEDGWICK, ss. contractor  
K.S. Martin, President of KAW Drilling Co., Inc. (Employer of contractor)  
of the above-described well, being first duly sworn on oath, says: That I have knowledge of the facts, statements, and matters herein contained and the log of the above-described well as filed and that the same are true and correct. So help me God.

(Signature) K.S. Martin  
K. S. Martin, President, 1010 Union Center  
(Address) Wichita, KS 67202

SUBSCRIBED AND SWORN TO before me this 4th day of August, 1981.

Mary Susan Whaley  
Mary Susan Whaley Notary Public.

My commission expires December 10, 1983



15.185.21324.0000

OPERATOR:	AMERICAN ENERGIES CORP.
CONTRACTOR:	KAW Drilling Co., Inc.
WELL NAME:	McGINTY #1-13
LOCATION:	SE SW NE Section 13-21S-14W Stafford County, Kansas
SPUD DATE:	July 23, 1981
COMPLETION DATE:	July 31, 1981


0 - 2745	Sand & Shale
2746 - 3681	Shale & Shell
3682 - 3740	Lime & Shale
3740	R.T.D.

Spud hole at 11:30 a.m. on July 23, 1981. Drilled 264 feet of 12½ inch hole. Ran 6 joints of 23 pound, 8 5/8 inch new surface casing. (Tallied at 249.71 feet.) Set at 261 feet with 200 sacks of 50/50 posmix, 3% Gel. Cement by Sun Cementing. Plug was down at 8:00 p.m. on July 23, 1981.


Total Depth 3740 feet. Set first plug at 740 feet with 50 sacks cement, second plug at 275 feet with 30 sacks, 10 sacks at 40 feet and 10 sacks in rat hole. Cement by Sun Cementing. Job completed at 6:30 p.m. on July 31, 1981. State plugger - Mr. Towman.

STATE OF KANSAS        )  
                                  ) ss  
COUNTY OF SEDGWICK )


I, K. S. Martin, President of KAW Drilling Co., Inc., being first duly sworn and upon my oath, state that: I have knowledge of the facts, statements and matters herein contained and the log of the above described well as filed and that the same are true and correct. So help me God.

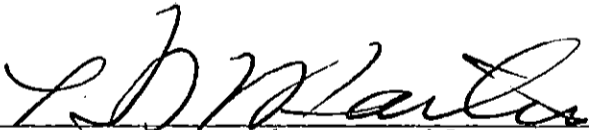  
\_\_\_\_\_  
K. S. Martin, President

SUBSCRIBED AND SWORN to before me on this 4<sup>th</sup> day of August, 1981.

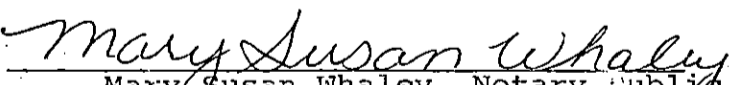  
\_\_\_\_\_  
Mary Susan Whaley, Notary Public

My Commission Expires:  
December 10, 1983

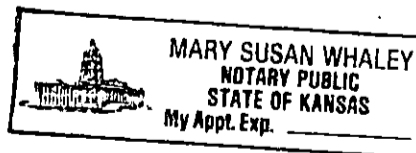

RECEIVED  
STATE CORPORATION COMMISSION  
AUG 5 1981  
CONSERVATION DIVISION  
Wichita, Kansas