


WELL PLUGGING RECORD

Give All Information Completely  
Make Required Affidavit  
Mail or Deliver Report to:  
Conservation Division  
State Corporation Commission  
211 No. Broadway  
Wichita, Kansas

STAFFORD County. Sec. 13 Twp. 21S Rge. 14 (E) (W)

Location as "NE/CNW/SW" or footage from lines NE NE NW  
Lease Owner HILTON DRILLING COMPANY, INC.  
Lease Name WRIGHT Well No. 1  
Office Address 925 PATTON, GREAT BEND, KANSAS  
Character of Well (completed as Oil, Gas or Dry Hole) DRY HOLE  
Date well completed JUNE 15 19 58  
Application for plugging filed JUNE 15 19 58  
Application for plugging approved JUNE 15 19 58  
Plugging commenced JUNE 15 19 58  
Plugging completed JUNE 15 19 58  
Reason for abandonment of well or producing formation DRY

NORTH

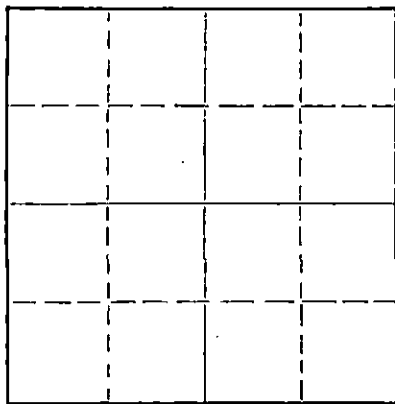

Locate well correctly on above  
Section Plat

If a producing well is abandoned, date of last production \_\_\_\_\_ 19\_\_\_\_  
Was permission obtained from the Conservation Division or its agents before plugging was commenced? YES

Name of Conservation Agent who supervised plugging of this well MR. BROADFOOT, ST. JOHN, KANSAS  
Producing formation \_\_\_\_\_ Depth to top \_\_\_\_\_ Bottom \_\_\_\_\_ Total Depth of Well 3740 Feet  
Show depth and thickness of all water, oil and gas formations.

OIL, GAS OR WATER RECORDS

CASING RECORD

FORMATION	CONTENT	FROM	TO	SIZE	PUT IN	PULLED OUT
				8-5/8"	239'	NOBE

Describe in detail the manner in which the well was plugged, indicating where the mud fluid was placed and the method or methods used in introducing it into the hole. If cement or other plugs were used, state the character of same and depth placed, from \_\_\_\_\_ feet to \_\_\_\_\_ feet for each plug set.

CEMENTED BOTTOM PLUG @ 210' WITH 20 SACKS CEMENT.  
TOP PLUG AT 35' WITH 10 SACKS CEMENT.

6-17-58

(If additional description is necessary, use BACK of this sheet)


Name of Plugging Contractor HILTON DRILLING COMPANY, INC.  
Address 925 PATTON, GREAT BEND, KANSAS

STATE OF KANSAS, COUNTY OF BARTON, ss.  
DAN COOK, VICE PRESIDENT (employee of owner) or (owner or operator) of the above-described well, being first duly sworn on oath, says: That I have knowledge of the facts, statements, and matters herein contained and the log of the above-described well as filed and that the same are true and correct. So help me God.

(Signature) [Signature]  
GREAT BEND, KANSAS  
(Address)

SUBSCRIBED AND SWORN TO before me this 16TH day of JUNE, 19 58.

My commission expires JANUARY 26, 1959 [Signature] Notary Public.

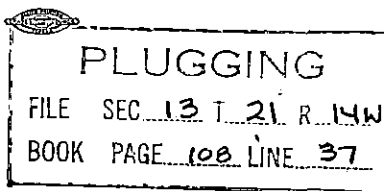

15.185.00483.0000

DRILLER'S LOG

COMPANY: HILTON DRILLING COMPANY, INC.  
CONTRACTOR: HILTON DRILLING COMPANY, INC.  
FARM NAME: WRIGHT # 1  
COMMENCED: MAY 28, 1958  
COMPLETED: JUNE 15, 1958

LOCATION: NE NE NW  
SECTION 13-21S-14W  
STAFFORD COUNTY, KS.  
ELEVATION: 1920 D. F.  
CASING USED: 8 5/8" @ 239' w/200 SACK

SAND AND CLAY	100
SHALE	240
SHALE AND SAND	245
RED BED SAND AND SHALE	815
ANHYDRITE	840
SHALE AND SHELLS	1210
LIME	1250
LIME AND SHALE	1550
LIME	1990
LIME AND SHALE	2105
LIME	2200
SHALE	2220
LIME	2330
LIME AND SHALE	2435
SHALE	2525
LIME AND SHALE	2785
LIME	3228
LIME AND SHALE	3270
SHALE AND SAND	3335
SHALE AND LIME	3380
LIME	3525
LIME AND CHERT	3615
CHERT, LIME AND SHALE	3652
SHALE AND LIME	3733
LIME	3740
TOTAL DEPTH	3740

RECEIVED  
STATE CORPORATION COMMISSION  
FEB 25 1959  
CONSERVATION DIVISION  

STATE OF KANSAS }  
COUNTY OF BARTON } ss.

I, THE UNDERSIGNED, BEING DULY SWORN ON OATH, STATE THAT THE ABOVE STATEMENT AND LOG ARE TRUE AND A CORRECT RECORD AND LOG OF THE WELL DRILLED AT THE LOCATION ABOVE DESCRIBED.

HILTON DRILLING COMPANY, INC.

E. M. HILTON, PRESIDENT

SUBSCRIBED AND SWORN TO BEFORE ME THIS DAY OF JUNE, 1958.

NOTARY PUBLIC

MY COMMISSION EXPIRES JANUARY 26, 1959.

PLUGGING  
FILE SEC 13 T 21 R 14W  
BOOK PAGE 108 LINE 37