


WELL PLUGGING RECORD

Give All Information Completely
Make Required Affidavit
Mail or Deliver Report to:
Conservation Division
State Corporation Commission
800 Bitting Building
Wichita, Kansas

Stafford County. Sec. 13 Twp. 21 Rge. (E) 14 (W)
Location as "NE/CNW $\frac{1}{4}$ SW $\frac{1}{4}$ " or footage from lines SW NW NW/4
Lease Owner Armer Drilling Company, Inc.
Lease Name Angeline Wright Well No. 1
Office Address 710 Petroleum Bldg, Wichita, Kansas
Character of Well (completed as Oil, Gas or Dry Hole) dry
Date well completed May 3 19 51
Application for plugging filed May 3 19 51
Application for plugging approved May 3 19 51
Plugging commenced May 4 19 51
Plugging completed May 8 19 51
Reason for abandonment of well or producing formation dry

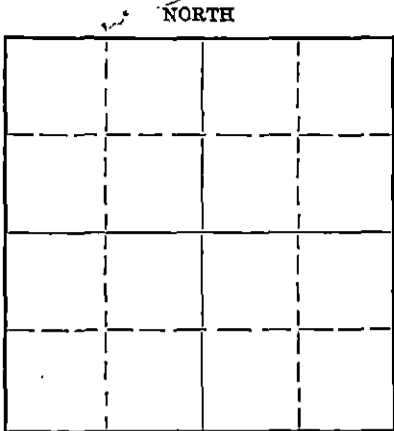

Locate well correctly on above Section Flat

If a producing well is abandoned, date of last production 19...
Was permission obtained from the Conservation Division or its agents before plugging was commenced? Yes

Name of Conservation Agent who supervised plugging of this well Eldon Petty
Producing formation... Depth to top 3687 $\frac{1}{2}$ Bottom 3689 $\frac{1}{2}$ Total Depth of Well 3689 $\frac{1}{2}$ Feet
Show depth and thickness of all water, oil and gas formations.

OIL, GAS OR WATER RECORDS

CASING RECORD

Formation	Content	From	To	Size	Put In	Pulled Out
				8-5/8	266	None
				5-1/2	3687 $\frac{1}{2}$	2805

Describe in detail the manner in which the well was plugged, indicating where the mud fluid was placed and the method or methods used in introducing it into the hole. If cement or other plugs were used, state the character of same and depth placed, from... feet to... feet for each plug set.

Plugged back with crushed rock from 3675 ft to 3480 ft.

Dumped 5 sacks cement at 3480 ft with dump bailer, top

of cement 3445 ft. Filled hole with mud to 250 ft, set

rock bridge, dumped 15 sacks cement, top of cement 200 ft.

filled with mud to 30 ft, dumped 10 sacks cement for cap.

RECEIVED
STATE CORPORATION COMMISSION

MAY 15 1951 5-15-51

CONSERVATION DIVISION
Wichita, Kansas

(If additional description is necessary, use BACK of this sheet)

Correspondence regarding this well should be addressed to: Armer Drilling Company, Inc.
Address 710 Petroleum Building, Wichita 2, Kansas

STATE OF KANSAS, COUNTY OF SEDGWICK, ss.


(employee of owner) or (owner or operator) of the above-described well, being first duly sworn on oath, says: That I have knowledge of the facts, statements, and matters herein contained and the log of the above-described well as filed and that the same are true and correct. So help me God.

(Signature) *L.P. Sprouling*
710 Petroleum Building, Wichita 2, Kansas
(Address)

SUBSCRIBED AND SWORN TO before me this 14th day of May, 1951

Doyle Walton
Notary Public.

My commission expires Sept. 17, 1951

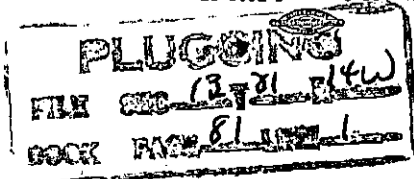

L O G

Company: M. B. Armer
 Contractor: M. B. Armer
 Drilling Commenced: 4/9/51
 Drilling Completed: 4/18/51
 Elevation: 1928 R. B.
 1926 D. F.
 1923 Gr.
 (Ideco rig)

Farm: Angeline Wright Well # 1
 Location: SW NW NW/4 Sec. 13-21S-14W
 Stafford County, Kansas
 Casing Record: 8 5/8" @ 266 ft. W/200 sacks
 cement; 5 1/2" @ 3690 - corr. to
 3687 1/2 ft. W/150 sacks cement

(figures below indicate bottoms)

Sand	195
Shale & shells	266
Sand & shale	400
Red bed, shale & shells	825
Anhydrite	845
Shale & shells	970
Shale, shells & red bed	1570
Lime & shale	2240
Shale & lime shells	2880
Lime & shale	3080
Lime	3125
Lime & shale	3365
Lime	3641
Simpson Sand	3675
Shale	3687
Sandy shale	3690
Dolomite	3692
R. T. D.	3692 corr. - 3689 1/2

FORMATION TOPS

Heebner	3234
Toronto	3256
Br. Lime	3353
Kansas City	3365
Conglomerate	3611
Simpson	3641
Arbuckle	3690 - corr. 3687 1/2

I hereby certify that this is a true and correct log of the above described well as shown by the drilling reports.

M. B. ARMER

By *M. B. Armer*
 STATE CORP.

MAY 15 1951

CONSERVATION DIVISION
 WICHITA, KANSAS

STATE OF KANSAS)
) ss:
 COUNTY OF SEDGWICK)

Subscribed and sworn to before me, a notary public, in and for said County and State this 27th day of April, 1951.

Harold Walton
 Notary Public

My commission expires Sept. 17, 1951.

