


Give All Information Completely
Make Required Affidavit
Mail or Deliver Report to:
Conservation Division
State Corporation Commission
800 Bitting Building
Wichita, Kansas

WELL PLUGGING RECORD

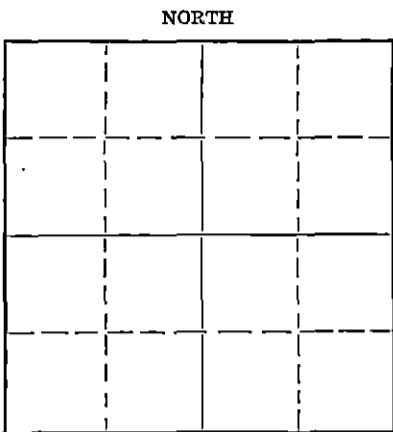

Locate well correctly on above Section Plat

Stafford County. Sec. 13 Twp. 21 Rge. 14 (E) (W)
Location as "NE/CNW $\frac{1}{4}$ SW $\frac{1}{4}$ " or footage from lines NW SE SE
Lease Owner Petroleum, Inc.
Lease Name McGinty Well No. 2
Office Address 100 Derby Bldg., Wichita, Kansas
Character of Well (completed as Oil, Gas or Dry Hole) Dry Hole
Date well completed November 12, 1951
Application for plugging filed November 12, 1951
Application for plugging approved November 14, 1951
Plugging commenced November 12, 1951
Plugging completed November 12, 1951
Reason for abandonment of well or producing formation Dry Hole

If a producing well is abandoned, date of last production 19...
Was permission obtained from the Conservation Division or its agents before plugging was commenced? Yes

Name of Conservation Agent who supervised plugging of this well Mr. C. D. Stough
Producing formation Depth to top Bottom Total Depth of Well 3691 Feet
Show depth and thickness of all water, oil and gas formations.

OIL, GAS OR WATER RECORDS

CASING RECORD

Formation	Content	From	To	Size	Put In	Pulled Out
				8 5/8"	220'	None

Describe in detail the manner in which the well was plugged, indicating where the mud fluid was placed and the method or methods used in introducing it into the hole. If cement or other plugs were used, state the character of same and depth placed, from feet to feet for each plug set.

Mudded up to 210'. Placed wooden plug at 210'. Cemented and displaced through drill pipe 15 sacks cement on top of plug at 210'.
Mudded up to 35'. Filled hole to bottom of cellar with 10 sax cement after placing second plug at 35'.

RECEIVED
STATE CORPORATION COMMISSION
NOV 16 1951
CONSERVATION DIVISION

(If additional description is necessary, use BACK of this sheet)
Correspondence regarding this well should be addressed to Petroleum, Inc.
Address 100 Derby Building, Wichita, Kansas

STATE OF KANSAS, COUNTY OF SEDGWICK, ss.
Eric H. Jager (employee of owner) or (owner or operator) of the above-described well, being first duly sworn on oath, says: That I have knowledge of the facts, statements, and matters herein contained and the log of the above-described well as filed and that the same are true and correct. So help me God.

(Signature) Eric H. Jager
100 Derby Building, Wichita, Kansas (Address)

SUBSCRIBED AND SWORN to before me this 16th day of November, 1951

Charlotta Heidman
Notary Public.

My commission expires October 13, 1954

PLUGGING
FILE SEC 13 T 21 R 14 W
BOOK PAGE 1241-6

WELL LOG MCGINTY #2

Petroleum, Inc., Lease Owner

Section 13, Twp.21S, Rge.14W

Garvey Oil, Contractor

Location: NW SE SE

Drilling Commenced: Nov. 1, 1951

County: Stafford

Drilling Completed: Nov. 12, 1951

Production: D & A

Casing: 221' of 8 5/8" w/175 sax

Rotary Total Depth: 3691'

All figures below indicate bottom of formation:

40 Surface Clay
 210 Sand
 250 Shale
 310 Sand
 312 Red Bed
 335 Anhydrite
 945 Shale & Shells
 1056 Shale & Red Bed
 1550 Shale & Shells
 1905 Lime & Shale
 2080 Lime
 2450 Lime & Shale
 2615 Shale & Shells
 2755 Lime & Shale
 3220 Lime
 3352 Lime & Shale
 3574 Lime
 3618 Lime - Chert
 3634 Chert
 3680 Lime
 3691 Shale & Lime

Tops:

Heebner: 3222 (-1296)
 Brown Lime: 3341 (-1415)
 Lansing: 3353 (-1427)
 Arbuckle: 3686 (-1760)

3691' R.T.D.

RECEIVED
 STATE CORPORATION COMMISSION
 NOV 16 1951
 CONSERVATION DIVISION
 Wichita, Kansas

I hereby certify that this is a true and correct log of the above mentioned well.

PETROLEUM, INC.

STATE OF KANSAS)
)
 COUNTY OF SEDGWICK)

SS.

By Eric H. Jager
 Eric H. Jager

Subscribed to and sworn to before me, a Notary Public, in said County and State, this 15th day of November, 1951.

PLUGGING
 FILE 320-13171-140
 BOOK PAGE 120-13171-4954
 October 15, 1954

My commission expires:

Notary Public