


WELL PLUGGING RECORD

Give All Information Completely  
Make Required Affidavit  
Mail or Deliver Report to:  
Conservation Division  
State Corporation Commission  
800 Bitting Building  
Wichita, Kansas

Stafford County. Sec. 13 Twp. 21 Rge. 14 (E) (W)  
Location as "NE/CNW $\frac{1}{4}$ SW $\frac{1}{4}$ " or footage from lines NW NE SE  
Lease Owner Petroleum, Inc.  
Lease Name McGinty Well No. 1  
Office Address 100 Derby Building, Wichita, Kansas  
Character of Well (completed as Oil, Gas or Dry Hole) Dry Hole  
Date well completed November 14, 1950  
Application for plugging filed November 20, 1950  
Application for plugging approved November 16, 1950  
Plugging commenced November 14, 1950  
Plugging completed November 14, 1950  
Reason for abandonment of well or producing formation Dry Hole

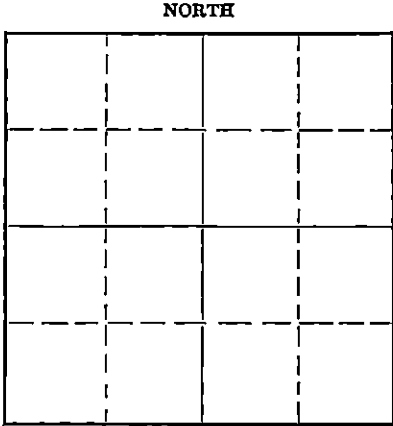

Locate well correctly on above  
Section Plat

If a producing well is abandoned, date of last production 19...  
Was permission obtained from the Conservation Division or its agents before plugging was commenced? Yes

Name of Conservation Agent who supervised plugging of this well Mr. C. D. Stough  
Producing formation Depth to top Bottom Total Depth of Well 3684 Feet  
Show depth and thickness of all water, oil and gas formations.

OIL, GAS OR WATER RECORDS

CASING RECORD

Formation	Content	From	To	Size	Put In	Pulled Out
				8 5/8"	220'	None

Describe in detail the manner in which the well was plugged, indicating where the mud fluid was placed and the method or methods used in introducing it into the hole. If cement or other plugs were used, state the character of same and depth placed, from... feet to... feet for each plug set.

Wooden plug set at 220'. Cemented and displaced through drill pipe 15 sax. Filled hole with heavy mud to 30'. Placed wooden plug at 30'. Filled hole to surface with cement.

RECEIVED  
STATE CORPORATION COMMISSION  
NOV 21 1950  
CONSERVATION DIVISION  
Wichita, Kansas

(If additional description is necessary, use BACK of this sheet)  
Correspondence regarding this well should be addressed to Petroleum, Inc.  
Address 100 Derby Building, Wichita, Kansas


STATE OF KANSAS, COUNTY OF SEDGWICK, ss.  
Eric H. Jager (employee of owner) or (owner or operator) of the above-described well,  
being first duly sworn on oath, says: That I have knowledge of the facts, statements, and matters herein contained and the log of the above-described well as filed and that the same are true and correct. So help me God.

(Signature) Eric H. Jager  
100 Derby Building, Wichita, Kansas  
(Address)

SUBSCRIBED AND SWORN to before me this 21st day of November 1950

Charlotte Heidman  
Notary Public.

My commission expires October 13, 1954

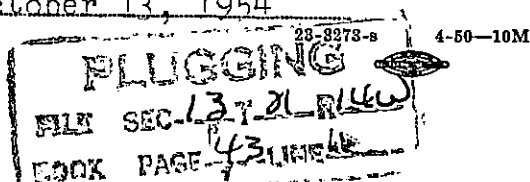

WELL LOG McGINTY #1

Petroleum, Inc., Lease Owner

Section 13, Twp. 21S, Rge. 14W

Garvey, Oil, Contractor

Location: NW NE SE

Rotary Total Depth: 3684'

County: Stafford

Casing: 220' of 8 5/8"

Elevation: 1922 D.F.

Commenced: November 4, 1950

Completed: November 14, 1950

Figures below indicate bottom of formation:

25	Surface Soil		
95	Sand		<u>Tops</u>
200	Sand & Clay	3224	Heebner
220	Shale & Shells	3243	Toronto
290	Sand	3263	Base Oread
390	Sand & Shale	3344	Br. Lime
815	Red Bed	3355	Lansing
835	Anhydrite	3564	B.K.C.
850	Red Bed	3590	Viola
1505	Shale & Shells	3624	Simpson
1735	Lime & Shale	3680	Arbuckle
3100	Lime		
3278	Lime & Shale		
3345	Shale		
3357	Lime		
3579	Lime & Shale		
3629	Shale		
3684	R.T.D.		

I hereby certify that this is a true and correct log of the above mentioned well.

PETROLEUM, INC.

*Eric H. Jager*  
Eric H. Jager

STATE OF KANSAS)

) SS.

SEDGWICK COUNTY)

Subscribed to and sworn to before me, a Notary Public in said County and State this 21st day of November, 1950.

**PLUGGING**

STATE OF KANSAS  
CORPORATION DIVISION

FILE SEC. 13 T. 21 R. 14

NOV 21 1950

BOOK PAGE 43 LINE 11

CONSERVATION DIVISION

*Charlotte Weidman*  
Notary Public

My commission expires: October 3, 1954