


STATE OF KANSAS
STATE CORPORATION COMMISSION

WELL PLUGGING RECORD

Give All Information Completely
Make Required Affidavit
Mail or Deliver Report to:
Conservation Division
State Corporation Commission
800 Bitting Building
Wichita, Kansas

Stafford County. Sec. 13 Twp. 21S Rge. 14 (E) 14 (W)
Location as "NE/CNW%SW%" or footage from lines SW $\frac{1}{4}$ -SE $\frac{1}{4}$ -NE $\frac{1}{4}$
Lease Owner Champlin Refining Company
Lease Name McGinty Well No. 1
Office Address P.O. Dr. #552, Enid, Oklahoma
Character of Well (completed as Oil, Gas or Dry Hole) Oil
Date well completed October 20, 19 50
Application for plugging filed July 9, 19 56
Application for plugging approved July 17, (Verbal) 19 56
Plugging commenced July 18, 19 56
Plugging completed July 21, 19 56
Reason for abandonment of well or producing formation Non commercial
production
If a producing well is abandoned, date of last production July 17, 19 56
Was permission obtained from the Conservation Division or its agents before plugging was commenced? Yes

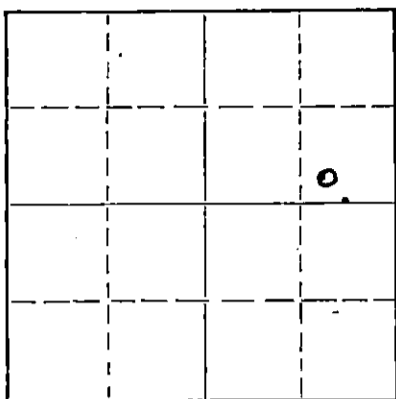

Locate well correctly on above
Section Plat

Name of Conservation Agent who supervised plugging of this well R. M. Brundege
Producing formation _____ Depth to top _____ Bottom _____ Total Depth of Well 3595 Feet
Show depth and thickness of all water, oil and gas formations.

OIL, GAS OR WATER RECORDS

CASING RECORD

FORMATION	CONTENT	FROM	TO	SIZE	PUT IN	PULLED OUT
				8 5/8" OD	341'	None
				5 1/2" OD	3677'	2745'

Describe in detail the manner in which the well was plugged, indicating where the mud fluid was placed and the method or methods used in introducing it into the hole. If cement or other plugs were used, state the character of same and depth placed, from _____ feet to _____ feet for each plug set.

Filled hole with sand from 3595' PBSD to 3469' and dumped 5 sacks of cement then filled with heavy mud from top of cement 3439' to 270' and set 5' rock bridge and 20 sacks of cement then filled hole with heavy mud to 35' and set 5' rock bridge and 10 sacks of cement filling hole to bottom of cellar.

(If additional description is necessary, use BACK of this sheet)

Name of Plugging Contractor Ace Pipe Pulling Company
Address Great Bend, Kansas

STATE OF Kansas, COUNTY OF Barton, ss.

J. W. Meyers (employee of owner) or (owner's operator) of the above-described well, being first duly sworn on oath, says: That I have knowledge of the facts, statements, and matters herein contained and the log of the above-described well as filed and that the same are true and correct. So help me God.

(Signature) [Signature]

P.O. Box 167, Ellinwood, Kansas
(Address)

SUBSCRIBED AND SWORN TO before me this 25th day of July, 19 56

My commission expires Sept. 10, 1959

[Signature] Notary Public.
RECEIVED
STATE CORPORATION COMMISSION

PLUGGING
FILE SEC. 13 T. 21 R. 14W
BOOK PAGE 19 LINE 6

JUL 27 1956
CONSERVATION DIVISION
Wichita, Kansas
7-26-56

TO KANSAS CORPORATION COMMISSION
 Conservation Division
 800 Bitting Building
 Wichita, Kansas

County Stafford SEC. 13 TWP. 21S RGE. 14W

COMPANY OPERATING Champlin Refining Company

OFFICE ADDRESS Dr. #552, Enid, Oklahoma

FARM NAME McGinty WELL NO. 1

WELL LOCATED 990' from the East Line and 2310' from the North Line

CHARACTER OF WELL Oil

DRILLING COMMENCED October 4, 1950 DRILLING COMPLETED October 20, 1950

SIZE	WEIGHT	THDS	MAKE	FT.	AMOUNT PULLED	CEMENT
8 5/8"	24#	8rd.	Natl. Tube	341'		300 sx.
5 1/2"	15.5#&14#	8rd.	Spang	3678.79'		150 sx.

FORMATION RECORD

TOPS	BOTTOM		TOPS	BOTTOM
0	- 225	Sand & Shells		
225	- 343	Shale & Sand		
343	- 745	Red Bed & Shale		
745	- 1325	Red Bed, Shale & Shells		
1325	- 1580	Shale Salt & Shells		
1580	- 1730	Shale & Lime		
1730	- 2070	Lime		
2070	- 2175	Lime & Shale		
2175	- 2570	Shale		
2570	- 2660	Shale & Lime		
2660	- 2865	Shale		
2865	- 2940	Lime & Shale		
2940	- 3080	Shale & Lime		
3080	- 3155	Lime & Shale		
3155	- 3200	Lime		
3200	- 3350	Lime & Shale		
3350	- 3595	Lime		
3595	- 3625	Lime, Chert & Shale		
3625	- 3641	Shale		
3641	- 3652	Sand		
3652	- 3680	Shale		
	3680	T.D.		
	3595	PBTD		

PLUGGING
 FILE SEC. 13 T. 21 R. 14W
 BOOK PAGE 79 LINE 6

Subscribed and sworn to before me
 this 10th day of July, 1956.

My commission expires Sept. 10, 1959

[Signature]
 Superintendent

[Signature]
 Notary Public