


STATE OF KANSAS
STATE CORPORATION COMMISSION

Give All Information Completely
Make Required Affidavit
Mail or Deliver Report to:
Conservation Division
State Corporation Commission
212 No. Market
Wichita, Kansas

WELL PLUGGING RECORD

Form CP-4
15-009-20065-0000

NORTH

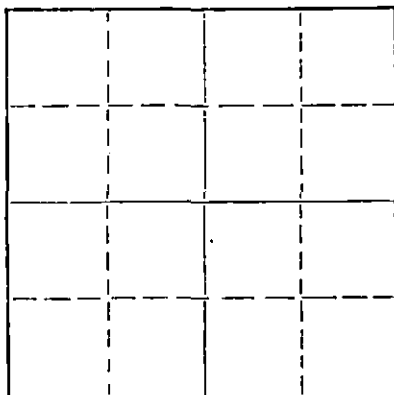

Locate well correctly on above
Section Plat

Barton County, Sec. 19 Twp. 16S Rge. (E) 12W (W)

Location as "NE/CNW/SW" or footage from lines SW NE NW
Lease Owner Circle Oil Company, Inc.
Lease Name REIF "B" Well No. 1
Office Address 500 Bitting Building, Wichita, Kansas
Character of Well (completed as Oil, Gas or Dry Hole) Dry Hole
Date well completed June 14, 19 67
Application for plugging filed 19
Application for plugging approved 19
Plugging commenced June 14, 19 67
Plugging completed June 14, 19 67
Reason for abandonment of well or producing formation Dry Hole

If a producing well is abandoned, date of last production 19
Was permission obtained from the Conservation Division or its agents before plugging was commenced? Yes (Don Truan)

Name of Conservation Agent who supervised plugging of this well

Producing formation Depth to top Bottom Total Depth of Well 3455' Feet

Show depth and thickness of all water, oil and gas formations.

OIL, GAS OR WATER RECORDS

CASING RECORD

FORMATION	CONTENT	FROM	TO	SIZE	PUT IN	PULLED OUT
	Surface Casing	0	303'	8-5/8"	6/8/67	-----

Describe in detail the manner in which the well was plugged, indicating where the mud fluid was placed and the method or methods used in introducing it into the hole. If cement or other plugs were used, state the character of same and depth placed, from feet to feet for each plug set.

Heavy Mud from Total Depth to 280 Feet; Halls,
Plug and 25 sacks Cement thru the Drill Pipe;
Heavy Mud to 40 Feet; 1/2 sack Halls, Plug and
10 sacks Cement to Base of Cellar; 2 sacks in
Rat Hole. (Job completed at 12:15 P.M.)

RECEIVED
STATE CORPORATION COMMISSION

JUN 20 1967

CONSERVATION DIVISION
Wichita, Kansas

(If additional description is necessary, use BACK of this sheet)

Name of Plugging Contractor Sage Drilling Co.
Address 500 Bitting Building, Wichita, Kansas

STATE OF KANSAS, COUNTY OF SEDGWICK, ss.
Lawrence F. Gray

(employee of owner) or (owner or operator) of the above-described well, being first duly sworn on oath, says: That I have knowledge of the facts, statements, and matters herein contained and the log of the above-described well as filed and that the same are true and correct. So help me God.

(Signature) Lawrence F. Gray
500 Bitting Bldg., Wichita, Kansas
(Address)

SUBSCRIBED AND SWORN TO before me this 19th day of June, 1967

My commission expires November 26, 1970.

Louise K. Whitted - Notary Public.

DRILLERS LOG

REIF "B" NO. 1

CASING RECORD:	COMPANY: Circle Oil Co., Inc.	DESCRIPTION:
8-5/8" @ 303'	CONTRACTOR: Sage Drilling Co.	SW NE NW
w/200 sax cement	COMMENCED: June 8, 1967	Sec. 19-16S-12W
TOTAL DEPTH:	COMPLETED: June 14, 1967	Barton County, Kansas
3455'		ELEVATION: 1915KB

<u>FORMATION</u>	<u>FROM</u>	<u>TO</u>	<u>REMARKS</u>
Surface Soil	0	303	
Sand & Shale	303	720	
Red Bed	720	858	
Anhydrite	858	887	
Shale	887	1520	
Lime & Shale	1520	2068	
Lime & Shale	2068	2220	
Shale & Lime	2220	2840	
Lime & Shale	2840	3190	
Lime	3190	3265	
Lime & Shale	3265	3455	D&A

RECEIVED
STATE CORPORATION COMMISSION

JUN 20 1967

CONSERVATION DIVISION
Wichita, Kansas

I certify that this is a true and correct copy of the above log to the best of my knowledge.

SAGE DRILLING CO., INC.

By Lawrence F. Gray
Lawrence F. Gray

Subscribed and sworn to before me this 19th day of June, 1967.

Louise K. Whitted
Louise K. Whitted, Notary Public

My commission expires:
November 26, 1970.