


STATE OF KANSAS  
STATE CORPORATION COMMISSION

Give All Information Completely  
Make Required Affidavit  
Mail or Deliver Report to  
Conservation Division  
State Corporation Commission  
800 Bitting Building  
Wichita, Kansas

WELL PLUGGING RECORD

Barton County. Sec. 16 Twp. 16S Rge. 12W (E) (W)  
Location as "NE/CNW/SW" or footage from lines NW NW SE  
Lease Owner Franco Central Oil Company  
Lease Name Meyers Well No. 1  
Office Address 512 Fourth Nat'l. Bank - Wichita, Kansas  
Character of Well (completed as Oil, Gas or Dry Hole) \_\_\_\_\_  
Date well completed \_\_\_\_\_ 19\_\_\_\_  
Application for plugging filed \_\_\_\_\_ 19\_\_\_\_  
Application for plugging approved \_\_\_\_\_ 19\_\_\_\_  
Plugging commenced March 2 1955  
Plugging completed March 9 1955  
Reason for abandonment of well or producing formation \_\_\_\_\_

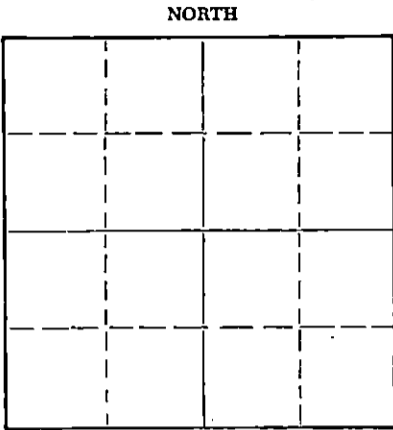

Locate well correctly on above  
Section Plat

If a producing well is abandoned, date of last production \_\_\_\_\_ 19\_\_\_\_  
Was permission obtained from the Conservation Division or its agents before plugging was commenced? Yes

Name of Conservation Agent who supervised plugging of this well Warren H. Horner  
Producing formation \_\_\_\_\_ Depth to top \_\_\_\_\_ Bottom \_\_\_\_\_ Total Depth of Well 3349 Feet  
Show depth and thickness of all water, oil and gas formations.

OIL, GAS OR WATER RECORDS

CASING RECORD

FORMATION	CONTENT	FROM	TO	SIZE	PUT IN	PULLED OUT
				10" OD	150'	None
				7" OD	3338'	2084'

Describe in detail the manner in which the well was plugged, indicating where the mud fluid was placed and the method or methods used in introducing it into the hole. If cement or other plugs were used, state the character of same and depth placed, from \_\_\_\_\_ feet to \_\_\_\_\_ feet for each plug set.

Filled the hole with sand from 3349' to 2990' and ran 5 sacks of cement. Pumped in 20 sacks of jell mud and 75 sacks of cement. Bailed hole to 41', set a rock bridge and ran 15 sacks of cement on top. Plugging completed.

(If additional description is necessary, use BACK of this sheet)

Name of Plugging Contractor West Supply Co., Inc.  
Address Chase, Kansas

STATE OF KANSAS, COUNTY OF SEDCWICK, ss.  
L. L. Livingston (employee of owner) or (owner) of the above-described well, being first duly sworn on oath, says: That I have knowledge of the facts, statements, and matters herein contained and the log of the above-described well as filed and that the same are true and correct. So help me God.

(Signature) L. L. Livingston  
512 Fourth Nat'l Bank Bldg., Wichita, Ks. (Address)

SUBSCRIBED AND SWORN TO before me this 11<sup>th</sup> day of March, 1955

My commission expires Oct 21, 1957

Rebecca Zies Notary Public.  
RECORDED  
STATE CORPORATION COMMISSION  
03-18-55  
CONSERVATION DIVISION  
Wichita, Kansas

PLUGGING  
FILE SEC 16 T 16 R 12W  
BOOK PAGE 54 LINE 45

WELL LOG BUREAU - KANSAS GEOLOGICAL SOCIETY  
 412 Union National Bank Bldg. Wichita, Kansas

Franco Central Oil Company  
 P. Meyers No. 1

Sec. 16 T. 16 R. 12N.  
 NW NW SE  
 330' fr. NL 330' fr. WL SE/4

Total Depth. 3353 - drilled deeper to 3378  
 Comm. 5-15-37 Comp. 6-26-37  
 Shot or Treated  
 Contractor Halmerich and Payne.  
 Issued 7-17-37

County: Barton

CASING.  
 9 5/8" 370'  
 7" 3338'

Elevation 1902  
 Production. Pot. 332 B.O.

Figures Indicate Bottom of Formations.

Shale and shells	385	Lime	3296
Shale and shells	605	Lime hard & shale	3332
Shale & shells red rock	795	Lime	3338
Shale and shells	806	core 3336-43 Rec. Total 4 1/2'	
Anhydrite	850	shy lime	3343
Shale and shells	1237	small show oil.	
Salt	1448	3343 equals 3344 SIC	
Shale and shells	1485	sand	3346
Sdy lime & pyrite	1560	1610' oil in 8 hours. Inc. to 1800'	
Shale lime & Pyrite	1670	oil in 1 1/2 hours. Increased to 1900'	
Sdy lime	1745	oil in total of 11 3/4 hrs.	
Sdy lime and shale	1820	shale and sand	3349
Lime	1835	2650' oil.	
Shale	1848	3349 equals 3350 SIC	
Lime	1859	shale	3359
Lime and shale	1950	Total Depth.	
Lime	1960		
Shale	1987	Drilled deeper	
Lime	2034		
Sdy lime	2042	Sand	3378
Lime	2058	Total depth	3378
Shale	2071	Top Gorham sand	3343
Sdy lime	2094	Top Basal Sand	3357
Red Rock	2107		
Shale and sdy lime	2172		
Shale and lime	2267		
Shale and lime	2333		
Lime	2335		
Lime and shale	2566		
Shale and lime	2598		
Cherty lime	2618		
Shale & cherty lime	2695		
Shale & cherty lime	2745		
Shale	2770		
Lime	2835		
Lime	2855		
Broken lime & shale	2925		
Shale and lime	2970		
Lime	3010		
Shale and lime	3046		
Shale	3076		
Shale and broken lime	3098		
Lime	3144		
Shale	3174		
Lime	3208		
Lime & shale	3248		

OCT 23 1937  
 KANSAS GEOLOGICAL SOCIETY  
 WICHITA, KANSAS

**PLUGGING**  
 NW SEC. 16 T. 16 R. 12N.  
 BOOK PAGE 57 LINE 45