

R

STATE OF KANSAS  
STATE CORPORATION COMMISSION

Give All Information Completely  
Make Required Affidavit  
Mail or Deliver Report to:  
Conservation Division  
State Corporation Commission  
211 No. Broadway  
Wichita, Kansas

WELL PLUGGING RECORD

Barton County, Sec. 16 Twp. 16 Rge. 12 (E) (W)

Location as "NE/CNW/SW" or footage from lines NW SW SW

Lease Owner Santa Fe Pipe & Supply

Lease Name Kultgen Well No. #2

Office Address Great Bend, Kansas

Character of Well (completed as Oil, Gas or Dry Hole) Oil

Date well completed \_\_\_\_\_ 19\_\_\_\_

Application for plugging filed \_\_\_\_\_ 19\_\_\_\_

Application for plugging approved \_\_\_\_\_ 19\_\_\_\_


Plugging commenced 9-22-61 1961

Plugging completed 9-27 1961

Reason for abandonment of well or producing formation Depleted

If a producing well is abandoned, date of last production \_\_\_\_\_ 19\_\_\_\_

Was permission obtained from the Conservation Division or its agents before plugging was commenced? Yes

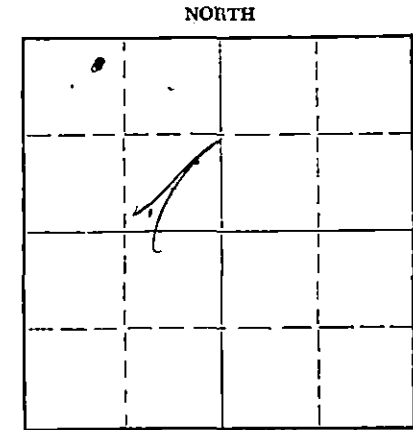

Locate well correctly on above  
Section Plat

Name of Conservation Agent who supervised plugging of this well Don Truan

Producing formation \_\_\_\_\_ Depth to top \_\_\_\_\_ Bottom \_\_\_\_\_ Total Depth of Well 3369 Feet

Show depth and thickness of all water, oil and gas formations.

OIL, GAS OR WATER RECORDS

CASING RECORD

FORMATION	CONTENT	FROM	TO	SIZE	PUT IN	PULLED OUT

Describe in detail the manner in which the well was plugged, indicating where the mud fluid was placed and the method or methods used in introducing it into the hole. If cement or other plugs were used, state the character of same and depth placed, from \_\_\_\_\_ feet to \_\_\_\_\_ feet for each plug set.

Filled hole sand to 3340'.  
Dumped 5 sacks cement  
Shot pipe 2881', 2817, and 2756'.  
Bridged hole at 325' with 10' rock  
and 25 sacks cement.  
Filled hole with mud to 30' 10 sacks  
cement.

12-21-61

(If additional description is necessary, use BACK of this sheet)

Name of Plugging Contractor Pipe Pullers, Inc.

Address Box 486, Ellinwood, Kansas

STATE OF Kansas, COUNTY OF Barton, ss.

Pipe Pullers, Inc. (employee of owner) or (owner or operator) of the above-described

well, being first duly sworn on oath, says: That I have knowledge of the facts, statements, and matters herein contained and the log of the above-described well as filed and that the same are true and correct. So help me God.

(Signature) Dean Kelly

(Address)

SUBSCRIBED AND SWORN TO before me this 6 day of October, 1961

My commission expires December 18, 1962

Juanita L Myers

Notary Public.



15-009-00745-00-00


COPY

Company- FRANCO CENTRAL OIL COMPANY  
Farm- Kultgen "D" No. 2

SEC. 16 T. 16 R. 12W  
NW SW SW

Total Depth. 3369  
Comm. 7-6-54 Comp. 7-15-54  
Shot or Treated.  
Contractor. The Carl Todd Drlg. Co.  
Issued. 8-21-54

County Barton KANSAS

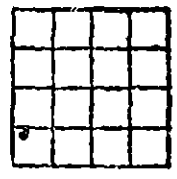

CASING:

Elevation. 1916

8 5/8" OD 338' cem. w/200 sx

Production. P. 30 BOPD / 2% wtr

Figures indicate Bottom of Formations.

clay, post rock	70
shale, shells	338
shale & shells	500
redbed	822
Anhydrite	850
shale	925
shale & shells	1335
shale, shells & salt	1480
lime & shale	1640
shale & shells	1750
salt & shale	1780
shale & lime	2365
shale	2550
lime & shale	2788
lime	2985
lime & shale	3085
lime	3346
Conglomerate	3365
sand	3369
Total depth	

Tops:	
Topoka	2720
Hoebner	2989
Brown lime	3078
Lansing	3098
Sand	3365

RECEIVED  
STATE CORPORATION COMMISSION  
DEC 21 1954  
CONSERVATION DIVISION  
Wichita, Kansas