

STATE OF KANSAS
STATE CORPORATION COMMISSION

Give All Information Completely
Make Required Affidavit
Mail or Deliver Report to:
Conservation Division
State Corporation Commission
800 Bittling Building
Wichita, Kansas

WELL PLUGGING RECORD

Barton County. Sec. 16 Twp. 16 Rge. (E) 12 (W)

Location as "NE/CNW 1/4 SW 1/4" or footage from lines Sec. NE

Lease Owner D. R. Lauck Oil Company Inc.

Lease Name Jarus Well No. 2

Office Address 520 Fourth Nat'l Bank Bldg. Wichita, 2 Kans

Character of Well (completed as Oil, Gas or Dry Hole) dry hole

Date well completed Nov. 1, 19 49

Application for plugging filed Nov. 1, 19 49

Application for plugging approved Nov. 1, 19 49

Plugging commenced Nov. 1, 19 49

Plugging completed Nov. 1, 19 49

Reason for abandonment of well or producing formation dry hole

If a producing well is abandoned, date of last production 19

Was permission obtained from the Conservation Division or its agents before plugging was commenced? yes

Name of Conservation Agent who supervised plugging of this well Stough

Producing formation none Depth to top Bottom Total Depth of Well 3395 Feet

Show depth and thickness of all water, oil and gas formations.

OIL, GAS OR WATER RECORDS

CASING RECORD

Formation	Content	From	To	Size	Put In	Pulled Out
Arbuckle Lime	water	3387	3395	10"	285'	none

Describe in detail the manner in which the well was plugged, indicating where the mud fluid was placed and the method or methods used in introducing it into the hole. If cement or other plugs were used, state the character of same and depth placed, from feet to feet for each plug set.

Mud	3395'	-	285	
Bridge	285	-	280	
Cement	280		240	
Mud	240		30	
Bridge	30		25	
Cement	25		6	bottom cellar

11-11-49

NOV 1 1949

(If additional description is necessary, use BACK of this sheet)

Correspondence regarding this well should be addressed to D. R. Lauck Oil Company Inc.
Address 520 Fourth Nat'l Bank Building Wichita 2 Kansas

STATE OF Kansas, COUNTY OF Sedgwick, ss.
D. R. Lauck (owner or operator) of the above-described well,


being first duly sworn on oath, says: That I have knowledge of the facts, statements, and matters herein contained and the log of the above-described well as filed and that the same are true and correct. So help me God.

(Signature) [Signature] President
Wichita, Kansas (Address)

SUBSCRIBED AND SWORN to before me this 10 day of November, 19 49

My commission expires Sept. 14, 1951

Notary Public.

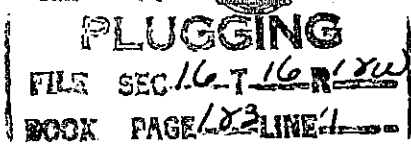

15-009-06371-00-00

D. H. LAUCK OIL COMPANY INC. et.al.

Jarus #2

Sec. 16 T16S. R12W. S16 NE
Barton County Kansas

Commenced: Oct. 20, 1949

Completed Nov. 1, 1949

Casing 10" 285' cemented 175 sacks

shale & red rock	65
shale & shells	175
sand	190
shale & shells	550
red rock	793
Anhydrite	825
shale & shells	1495
lime & shale	1900
lime	1940
lime & shale	2460
black shale	2475
lime & shale	2750
lime	3341
Conglomerate	3389
lime	

total depth
dry & abandoned

Johnston test 3083-97
30" 15 feet mud with
very slight rainbow

Tops-Derrick floor

Heebner	2974
Brown lime	3062
white lime	3081
Conglomerate	3339
Arbuckle	3387
Total depth	3395

RECEIVED

NOV 1 1949

STATE COMMISSION
KANSAS

PLUGGING
16.7 16.7 182