


Give All Information Completely
Make Required Affidavit
Mail or Deliver Report to:
Conservation Division
State Corporation Commission
800 Bittling Building
Wichita, Kansas

OR
FORMATION PLUGGING RECORD

Strike out upper line
when reporting plugging
of formations.

NORTH

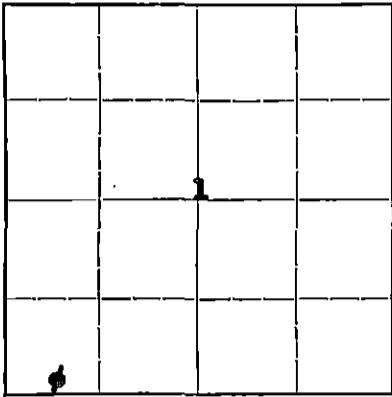

Locate well correctly on above
Section Plat

Rice County, Sec. 1 Twp. 21 Rge. 7 (E) W (W)
Location as "NE $\frac{1}{4}$ NW $\frac{1}{4}$ SW $\frac{1}{4}$ " or footage from lines C S $\frac{1}{2}$ SW $\frac{1}{4}$ SW $\frac{1}{4}$
Lease Owner The Dickey Oil Company
Lease Name Brothers Well No. 2
Office Address
Character of Well (completed as Oil, Gas or Dry Hole) Dry Hole
Date, well completed June 24, 1941 19
Application for plugging filed June 24, 1941 19
Application for plugging approved June 25, 1941 19
Plugging Commenced July 2, 1941 19
Plugging Completed July 4, 1941 19
Reason for abandonment of well or producing formation Dry

If a producing well is abandoned, date of last production 19
Was permission obtained from the Conservation Division or its agents before plugging was commenced? Yes

Name of Conservation Agent who supervised plugging of this well Ruel Durkee
Producing formation Conglomerate Depth to top 3437 Bottom 3452 Total Depth of Well 3485 Feet
Show depth and thickness of all water, oil and gas formations.

OIL, GAS OR WATER RECORDS

CASING RECORD

| Formation | Content | From | To | Size | Put In | Pulled Out |
|-----------|---------|------|------|-------------------|--------|-------------------------------|
| | | Top | 137' | 8 $\frac{1}{2}$ " | 137'2" | cemented with 60 sacks cement |
| | | Top | 3437 | 5-3/16" | 3437' | 1844.10' |

Describe in detail the manner in which the well was plugged, indicating where the mud fluid was placed and the method or methods used in introducing it into the hole. If cement or other plugs were used, state the character of same and depth placed, from _____ feet to _____ feet for each plug set.

Hole filled with heavy mud to 3460'; cement plug from 3460 to 3404' with 8 sacks cement; heavy mud from 3404' to 200'; cement plug from 200' to 170' with 10 sacks of cement; mud from 170' to 14', cement from 14' to cellar base with 6 sacks cement.

(If additional description is necessary, use BACK of this sheet)

Correspondence regarding this well should be addressed to The Dickey Oil Company
Address Ellis-Singleton Building
Wichita, Kansas

STATE OF KANSAS, COUNTY OF SEDGWICK, ss.

(employee of owner) ~~no longer employed~~ of the above-described well, being first duly sworn on oath, says: That I have knowledge of the facts, statements, and matters herein contained and the log of the above-described well as filed and that the same are true and correct. So help me God.

(Signature) Wayne Bradley
Ellis-Singleton Bldg, Wichita, Kansas
(Address)

SUBSCRIBED AND SWORN to before me this 14th day of July, 1941

Paul W. Keenling
Notary Public

My commission expires August 2, 1941

15.159.03523.0000

THE DICKEY OIL COMPANY

Producers and Refiners



WICHITA, KANSAS

July 14, 1941

ADDRESS ALL COMMUNICATIONS
TO GENERAL OFFICE

Conservation Division
State Corporation Commission
800 Bitting Building
Wichita, Kansas

Gentlemen:


We are enclosing Plugging Report on the Brothers Well No. 2
located in Rice County, Kansas.

Very truly yours

THE DICKEY OIL COMPANY


H. DUNGAN, Secretary

HD:ML

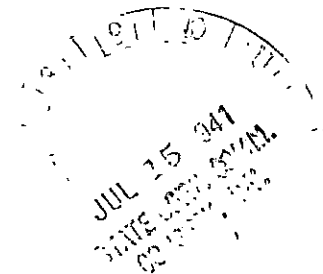

1 21 7W
143 20

THE DICKEY OIL COMPANY

Brothers Well #2

COMMENCED: 5/29/41
 COMPLETED: 6/13/41

LOCATION: C/S, SW, SW, 1-21-7
 Rice County, Kansas
 ELEVATION:

| | |
|---------------------------|------|
| shale | 40 |
| sand and shells | 65 |
| shale and red bed, shells | 137 |
| shells and red rock | 230 |
| shale and shells | 375 |
| red bed and shale | 680 |
| shale and salt | 775 |
| shale and shells | 1045 |
| lime and shale | 1125 |
| lime and shale breaks | 1230 |
| shale and lime | 1610 |
| shale and shells | 1825 |
| shale and lime | 1900 |
| shale and shells | 1995 |
| shale | 2327 |
| lime and shale | 2365 |
| broken lime and shale | 2430 |
| shale and lime | 2510 |
| lime | 2555 |
| shale and lime | 2615 |
| lime | 2660 |
| broken lime | 2670 |
| lime | 2760 |
| shale and shells | 2830 |
| shale | 2970 |
| lime | 2995 |
| lime and shale | 3040 |
| lime | 3225 |
| lime and shale | 3255 |
| lime | 3300 |
| not logged | 3360 |
| shale and lime | 3390 |
| shale and red rock | 3409 |
| false conglomerate | 3417 |
| shale | 3419 |
| shale and red bed | 3437 |
| cherty conglomerate | 3439 |
| T.D. | 3439 |



PI...ING
 FIL 1 217-744
 BOOK 143 WE-20