


WELL PLUGGING RECORD

Give All Information Completely
Make Required Affidavit
Mail or Deliver Report to:
Conservation Division
State Corporation Commission
800 Bitting Building
Wichita, Kansas

NORTH

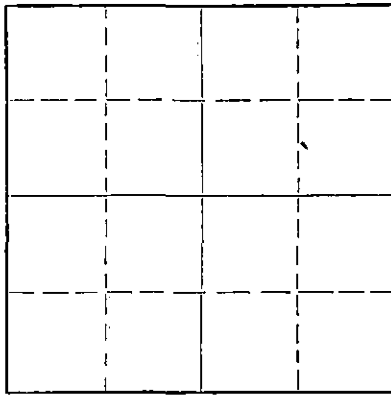

Locate well correctly on above
Section Plat

Stafford County. Sec. 9 Twp. 21 Rge. 13 (X) W (W)
Location as "NE/CNW/SW" or footage from lines NE NE NE
Lease Owner Hilton Drilling Company, Inc.
Lease Name Fanshier Well No. 1
Office Address 2121 10th Street Great Bend, Kansas
Character of Well (completed as Oil, Gas or Dry Hole) Dry Hole
Date well completed November 3, 19 53
Application for plugging filed November 27, 19 53
Application for plugging approved November 28, 19 53
Plugging commenced December 6, 19 53
Plugging completed December 11, 19 53
Reason for abandonment of well or producing formation Dry Hole

If a producing well is abandoned, date of last production _____ 19 ____
Was permission obtained from the Conservation Division or its agents before plugging was commenced? yes

Name of Conservation Agent who supervised plugging of this well M. A. Rives
Producing formation _____ Depth to top _____ Bottom _____ Total Depth of Well 3589 Feet
Show depth and thickness of all water, oil and gas formations.

OIL, GAS OR WATER RECORDS

CASING RECORD

FORMATION	CONTENT	FROM	TO	SIZE	PUT IN	PULLED OUT
		0	152'	8 5/8"	152'	none
		152'	3460'	5 1/2"	3460'	2656'

Describe in detail the manner in which the well was plugged, indicating where the mud fluid was placed and the method or methods used in introducing it into the hole. If cement or other plugs were used, state the character of same and depth placed, from _____ feet to _____ feet for each plug set.

Plugged 5 1/2" back with rock to 3275'. Mixed and dumped 5 sx. cement. Mudded hole to 1747', with pump. Mudded and bailed surface. Used pump truck to plug surface. Mixed and pumped in 10 sx. gel mud. Put in plug. Mixed and pumped in 75 sx. cement. Cement settled 31'. Mixed and put in 10 sx. cement.

RECEIVED
STATE OF KANSAS

1-16-54

(If additional description is necessary, use BACK of this sheet)

Name of Plugging Contractor Ace Pipe Pulling Company
Address P. O. Box 304, Great Bend, Kansas


STATE OF KANSAS, COUNTY OF BARTON, ss.
Henry Peacock, Secretary (employee of owner) or (owner or operator) of the above-described well, being first duly sworn on oath, says: That I have knowledge of the facts, statements, and matters herein contained and the log of the above-described well as filed and that the same are true and correct. So help me God.

(Signature) Henry Peacock
Great Bend, Kansas (Address)

SUBSCRIBED AND SWORN TO before me this 15th day of December, 19 53.

Margaret Whitmore
Notary Public.

My commission expires April 4, 1956.

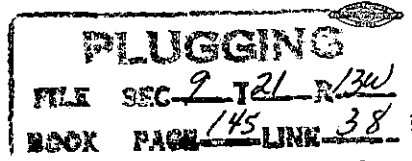

COPY

COPY

COPY

D R I L L E R ' S L O G

COMPANY: HILTON DRILLING COMPANY, INC.

LOCATION: NE NE NE 9-13-21
Stafford County, Kans.

CONTRACTOR: HILTON DRILLING COMPANY, INC.

ELEVATION: 1885 DF

FARM NAME: FANSHIER NO. 1

COMMENCED: 10-23-53

COMPLETED: 11-3-53

Casing Used: 8 5/8" @ 152'w/150 sx.
5 1/2" @ 3460'w/100 sx.

Top Sand	41
Sand and Clay	70
Sand, Clay, Sand rock	140
Shale	153
Blue Shale	215
Sand and Shale	276
Red Bed	285
Red Bed and Shells	739
Chalk	743
Anhydrite	765
Red Bed and Shale	870
Shells and Shale	1100
Shale and Salt	1400
Shale and Shells	1525
Shale and Brown Lime	1570
Lime	1780
Brown Lime	1985
Florence Flint	2000
Lime	2115
Brown Lime and Shale	2305
Shale and Lime Shells	2595
Shale and Brown Lime	2620
Lime and Shale	2755
Shale and Lime Shells	2881
Topeka Lime	2915
Lime	3065
Lime and Shale	3274
Lime	3543
Conglomerate, Shale, Lm.	3586
Conglomerate	3589
Total Depth	3589

STATE OF KANSAS
COUNTY OF BARTON

STATE OF KANSAS)
) SS
COUNTY OF BARTON)

I, the undersigned, being duly sworn on oath, state that the above statement and log are true and a correct record and log of the well drilled at the location above described.

PLUGGING
FILE SEC 9 T 21 R 13W
BOOK PAGE 145 LINE 38

HILTON DRILLING COMPANY, INC.

Henry Peacock
Henry Peacock, Secretary

Subscribed and sworn to before me this 5th day of November, 1953.

My commission expires 4-4-56.

Margaret Whitson
Notary Public