


STATE OF KANSAS  
STATE CORPORATION COMMISSION

WELL PLUGGING RECORD

Give All Information Completely  
Make Required Affidavit  
Mail or Deliver Report to:  
Conservation Division  
State Corporation Commission  
800 Bitting Building  
Wichita, Kansas

Stafford County, Sec. 9 Twp. 21 Rge. 13 (E) (W)

Location as "NE/CNW/SW" or footage from lines SW NW SE  
Lease Owner Petroleum, Inc.  
Lease Name Fanshier 'B' Well No. 1  
Office Address 305 East Third, Wichita, Kansas  
Character of Well (completed as Oil, Gas or Dry Hole) Dry Hole  
Date well completed April 8, 1953  
Application for plugging filed April 8, 1953  
Application for plugging approved April 8, 1953  
Plugging commenced April 8, 1953  
Plugging completed April 8, 1953  
Reason for abandonment of well or producing formation Dry Hole

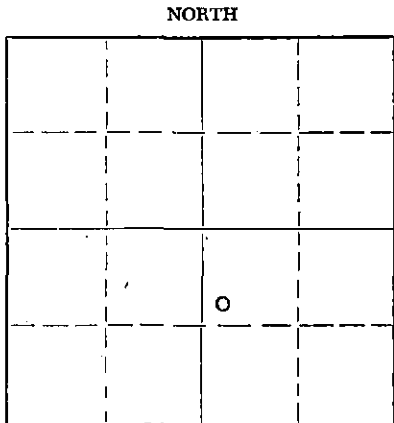

Locate well correctly on above  
Section Plat

If a producing well is abandoned, date of last production 19  
Was permission obtained from the Conservation Division or its agents before plugging was commenced? Yes

Name of Conservation Agent who supervised plugging of this well Mr. M. A. Rives  
Producing formation \_\_\_\_\_ Depth to top \_\_\_\_\_ Bottom \_\_\_\_\_ Total Depth of Well 3676 Feet  
Show depth and thickness of all water, oil and gas formations.

OIL, GAS OR WATER RECORDS

CASING RECORD

FORMATION	CONTENT	FROM	TO	SIZE	PUT IN	PULLED OUT
				8 5/8"	283'	None

Describe in detail the manner in which the well was plugged, indicating where the mud fluid was placed and the method or methods used in introducing it into the hole. If cement or other plugs were used, state the character of same and depth placed, from \_\_\_\_\_ feet to \_\_\_\_\_ feet for each plug set.

Mudded up to 270' and set wooden plug at  
270'. Placed 1/4 sack hulls on top of plug  
at 270'. Mudded up to 35', and set second  
wooden plug. Placed 1/4 sack hulls on top  
of plug at 35'. Filled hole to bottom of  
well cellar with 10 sacks cement.

APR 10 1953  
CONSERVATION DIVISION  
Wichita, Kansas

(If additional description is necessary, use BACK of this sheet)  
Name of Plugging Contractor Garvey Drilling Company  
Address R. R. #2, Great Bend, Kansas

4-18-53

STATE OF KANSAS, COUNTY OF SEDGWICK, ss.  
W. W. Fisher (employee of owner) of the above-described well, being first duly sworn on oath, says: That I have knowledge of the facts, statements, and matters herein contained and the log of the above-described well as filed and that the same are true and correct. So help me God.

(Signature) W W Fisher  
305 East Third, Wichita, Kansas  
(Address)

SUBSCRIBED AND SWORN TO before me this 15th day of April, 1953  
Charlotte Mearns  
Notary Public.

My commission expires October 13, 1954

PLUGGING  
FILE SEC 9 T 21 R 13 W  
BOOK PAGE 21 LINE 38

DRILLER'S LOG FANSHIER 'B' #1

Petroleum, Inc., Operator  
Garvey Drilling Company, Contractor  
Drilling Commenced: March 26, 1953  
Drilling Completed: April 8, 1953  
Casing Record: 8 5/8" @ 283' w/225 sax

Section 9, Twp. 21S, Rge. 13W  
Location: SW NW SE  
County: Stafford County, Kansas  
R.T.D.: 3676'  
Production: D & A

Figures below indicate bottom of formation:

123 Sand  
135 Hard Sand  
230 Shale  
270 Sand & Shale  
283 Shale & Shells  
773 Red Bed & Shale  
792 Anhydrite  
1765 Shale & Shells  
2030 Lime  
2970 Lime & Shale  
3475 Lime  
3145 Lime & Shale  
3676 Lime  
  
3676' R.T.D.

Tops:

Heebner: 3195 (-1299)  
Brown Lime: 3317 (-1421)  
Lansing: 3329 (-1434)  
Arbuckle: 3639 (-1743)

I hereby certify that this is a true and correct log of the above mentioned well.

PETROLEUM, INC.

By W. W. Fisher

STATE OF KANSAS )  
                          ) SS:  
COUNTY OF SEDGWICK )

Subscribed to and sworn to before me, a Notary Public, in said County and State, this 16th day of April, 1953.

Charlotte Friedman  
Notary Public

My commission expires: October 13, 1954.

RECEIVED  
REGISTRATION COMMISSION

APR 16 1953

REGISTRATION DIVISION  
Stafford County, Kansas

**PLUGGING**  
FILE SEC 9 T 21 R 13 W  
BOOK PAGE 97 LINE 38