


Give All Information Completely
Make Required Affidavit
Mail or Deliver Report to:
Conservation Division
State Corporation Commission
211 N. Broadway
Wichita, Kansas

WELL PLUGGING RECORD

T - 21 NORTH R - 13W

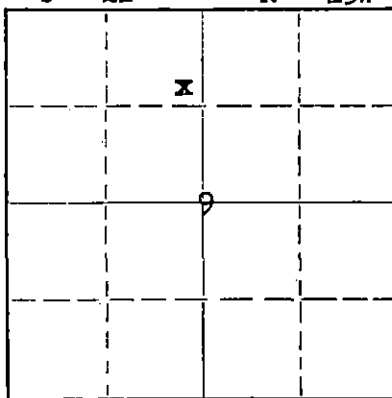

Locate well correctly on above Section Plat

Stafford County. Sec. 9 Twp. 21 Rge. (E) 13 (W)
Location as "NE/CNW/SW" or footage from lines SE - NE - NW
Lease Owner Frank J. Black
Lease Name Fanshier Well No. 1
Office Address McPherson, Kansas
Character of Well (completed as Oil, Gas or Dry Hole) Oil
Date well completed Aug. 26 1956
Application for plugging filed June 11 1956
Application for plugging approved June 12 1956
Plugging commenced June 20 1958
Plugging completed June 25 1958
Reason for abandonment of well or producing formation Unprofitable

If a producing well is abandoned, date of last production 19
Was permission obtained from the Conservation Division or its agents before plugging was commenced? Yes

Name of Conservation Agent who supervised plugging of this well Frank Brodfoot
Producing formation Depth to top Bottom Total Depth of Well 3649 Feet
Show depth and thickness of all water, oil and gas formations.

OIL, GAS OR WATER RECORDS

CASING RECORD

FORMATION	CONTENT	FROM	TO	SIZE	PUT IN	PULLED OUT
				8 5/8	197	None
				5 1/2	3595	2858.52

Describe in detail the manner in which the well was plugged, indicating where the mud fluid was placed and the method or methods used in introducing it into the hole. If cement or other plugs were used, state the character of same and depth placed, from feet to feet for each plug set.

Sanded to 3585' - dumped 5 sx cement - pulled pipe - pumped in 15 sx mud and 70 sx cement.

(If additional description is necessary, use BACK of this sheet)
Name of Plugging Contractor R & D Casing Pulling Company License # 236
Address Box 569 Ellinwood, Kansas

STATE OF KANSAS, COUNTY OF MCPHERSON, ss.
(employee of owner) or (owner or operator) of the above-described well, being first duly sworn on oath, says: That I have knowledge of the facts, statements, and matters herein contained and the log of the above-described well as filed and that the same are true and correct. So help me God.

(Signature) *[Handwritten Signature]*
(Address)

SUBSCRIBED AND SWORN TO before me this 30 day of June

My commission expires 2-15-62

RECEIVED
STATE CORPORATION COMMISSION
Notary Public
JUL 1 1958

PLUGGING
FILE SEC 9 T. 21 R. 13W
BOOK PAGE 107 LINE 26

CONSERVATION DIVISION
Wichita, Kansas
7-1-58

WELL LOG BUREAU—KANSAS GEOLOGICAL SOCIETY
508 East Murdock, Wichita, Kansas


COPY

Company- SIERRA PETROLEUM CO., INC.
Farm- Fanshier No. 1

SEC. 9 T. 21 R. 13W
SE NE NW

Total Depth. 3649
Comm. 8-14-56 Comp. 8-26-56
Shot or Treated.
Contractor.
Issued. 11-3-56

County Stafford
KANSAS

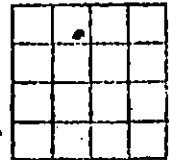

CASING:

8 5/8" 197' cem w/320 sx.
5 1/2" 3595' cem w/125 sx.

Elevation. 1892 KB

Production. 25 BOPD

Figures indicate Bottom of Formations.

sand	115
parties iron, shale	135
shale	197
shale, sand	295
shale	350
sand	460
red bed, sand	765
anhydrite	790
shale, shells	1605
lime, shale	1980
lime	2085
lime shale	3357
lime	3558
conglomerate	3589
Arbuckle	3595
lime	3649
Total Depth	

Tops:	
Anhydrite	765
Heebner	3171
Brown lime	3299
Kansas City	3312
Arbuckle	3589

RECEIVED
STATE CONSERVATION COMMISSION

JUN 12 1958

CONSERVATION DIVISION
Wichita, Kansas

PLUGGING
FILE SEC. 9 T. 21 R. 13W
BOOK PAGE 107 LINE 26