

Give All Information Completely
Make Required Affidavit
Mail or Deliver Report to:
Conservation Division
State Corporation Commission
212 North Market, Insurance Bldg.
Wichita, Kansas

WELL PLUGGING RECORD

Rice County. Sec. 27 Twp. 21 Rge. 7W (E) (W)

Location as "NE/CNW/SW" or footage from lines NE NE SW

Lease Owner Se Ro Bee Drilling Co., Inc.

Lease Name Howe Well No. 1

Office Address 606 Union National Bank Bldg, Wichita, Kansas

Character of Well (completed as Oil, Gas or Dry Hole) oil

Date well completed 19

Application for plugging filed November 7 19 59

Application for plugging approved November 9 19 59

Plugging commenced November 12 19 59


Plugging completed November 13 19 59

Reason for abandonment of well or producing formation dry

If a producing well is abandoned, date of last production 19

Was permission obtained from the Conservation Division or its agents before plugging was commenced? yes

NORTH

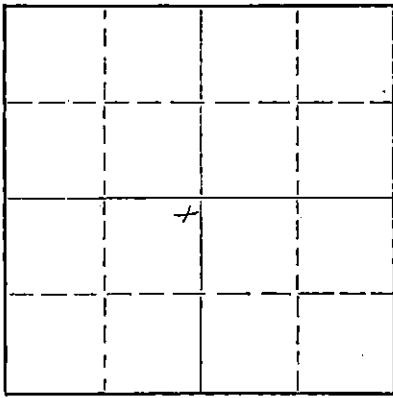

Locate well correctly on above Section Plat

Name of Conservation Agent who supervised plugging of this well Gilbert Toman

Producing formation Depth to top Bottom Total Depth of Well 3435 Feet

Show depth and thickness of all water, oil and gas formations.

OIL, GAS OR WATER RECORDS

CASING RECORD

FORMATION	CONTENT	FROM	TO	SIZE	PUT IN	PULLED OUT

Describe in detail the manner in which the well was plugged, indicating where the mud fluid was placed and the method or methods used in introducing it into the hole. If cement or other plugs were used, state the character of same and depth placed, from feet to feet for each plug set.

Sanded back to 3400' mixed and dumped 5 sacks cement
Mud to 200' set 10' rock bridge mixed and run 20 sacks cement
mud to 40' set 10' rock bridge with 10 sacks cement

RECEIVED
STATE CORPORATION COMMISSION
NOV 25 1959
CONSERVATION DIVISION
Wichita, Kansas

(If additional description is necessary, use BACK of this sheet)

Name of Plugging Contractor Southwest Casing Pulling Co., Inc.

Address Box 364, Great Bend, Kansas

STATE OF Kansas, COUNTY OF Barton, ss.

Southwest Casing Pulling Co., Inc. (employee of owner) or (owner or operator) of the above-described well, being first duly sworn on oath, says: That I have knowledge of the facts, statements, and matters herein contained and the log of the above-described well as filed and that the same are true and correct. So help me God.

(Signature) Roy L. Myers Sec. Treas.

Box 364, Great Bend, Kansas (Address)

SUBSCRIBED AND SWORN TO before me this 24 day of November, 19 59

My commission expires December 18, 1962

Notary Public.

15159.00116.0000

WELL LOG BUREAU—KANSAS GEOLOGICAL SOCIETY
508 East Murdock, Wichita, Kansas


Company: SeRoBee DRILLING CO., INC.
Farm: Howe No. 1

SEC. 27 T. 21 R. 7W
NE NE SW

Total Depth. 3437'
Comm. 11-22-58 Comp. 12-4-58
Shot or Treated.
Contractor.
Issued. 4-16-60

County Rice

KANSAS

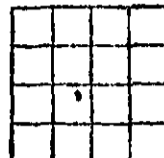

Elevation. 1610 RB

Production. 6 BOPD

CASING:
8 5/8" 175' cem. w/150 sx.
5 1/2" 3419

Figures indicate Bottom of Formations.

sand & shale	100
shale, red bed lime	175
lime & shale	2530
lime	2590
lime & shale	2706
chert	3437RTD
Total Depth	

TOPS: SCOUT	
Heebner	2706
Toronto	2721
Douglas	2740
Brown Lime	2858
Lansing	2890
Conglomerate Shale	3409
Conglomerate Chert	3414
Mississippi	3430

RECEIVED
STATE CORPORATION COMMISSION

FEB 22 1966

RESERVATION DIV.
Wichita, Kansas