


WELL PLUGGING RECORD

Give All Information Completely
Make Required Affidavit
Mail or Deliver Report to:
Conservation Division
State Corporation Commission
800 Biting Building
Wichita, Kansas

Rice County, Sec. 27 Typ. 21 Rge. 7 (E) (W)

Location as "NE/CNW/SW" or footage from lines N $\frac{1}{2}$ of NW $\frac{1}{4}$
Lease Owner McPherson Oil Co.
Lease Name Gregg Well No. 1
Office Address Box 190, Herington, Kansas
Character of Well (completed as Oil, Gas or Dry Hole) Dry Hole
Date well completed 1-7 19 53
Application for plugging filed 1-31 19 53
Application for plugging approved 2-2 19 53
Plugging commenced 2-3 19 53
Plugging completed 2-7 19 53
Reason for abandonment of well or producing formation Dry Hole

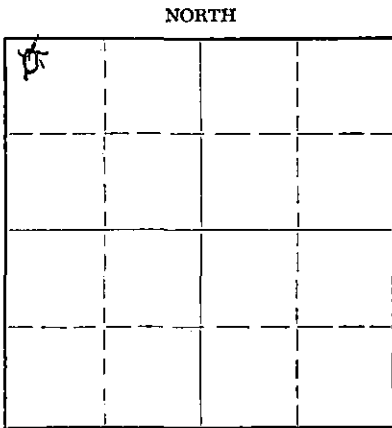

Locate well correctly on above Section Plat

If a producing well is abandoned, date of last production 19
Was permission obtained from the Conservation Division or its agents before plugging was commenced? yes

Name of Conservation Agent who supervised plugging of this well Ruel Durkee
Producing formation _____ Depth to top _____ Bottom _____ Total Depth of Well 3455 Feet
Show depth and thickness of all water, oil and gas formations.

OIL, GAS OR WATER RECORDS

CASING RECORD

FORMATION	CONTENT	FROM	TO	SIZE	PUT IN	PULLED OUT
				8 5/8	113	none
				5 1/2	3380	3025

Describe in detail the manner in which the well was plugged, indicating where the mud fluid was placed and the method or methods used in introducing it into the hole. If cement or other plugs were used, state the character of same and depth placed, from _____ feet to _____ feet for each plug set.

Filled hole from 3455 to 3370 with sand. Dumped six sacks cement.

Ripped 5 1/2 casing @ 3025 pulled out 5 1/2. Mudded then finished pulling

5 1/2. Filled with mud to 150'. Set bridge at 150'. Filled with rock

to 140'. Dumped 25 sacks cement. Put sacks in hole. Shoved to

115'. Filled with mud to surface. Set bridge at top of surface and

capped with 5 sacks cement.

RECEIVED
STATE CORPORATION COMMISSION

FEB 21 1953 2-20-53

Name of Plugging Contractor The McPherson Oil Co.
Address Box 190, Herington, Kansas

STATE OF Kansas, COUNTY OF Dickinson, ss.
J. S. Gling (employee of owner) or (owner or operator) of the above-described well, being first duly sworn on oath, says: That I have knowledge of the facts, statements, and matters herein contained and the log of the above-described well as filed and that the same are true and correct. So help me God.

(Signature) McPherson Oil Co. By J. S. Gling
Box 190, Herington, Kansas
(Address)

SUBSCRIBED AND SWORN TO before me this 18 day of February, 19 53

Eddlene M. Maloy
Notary Public.

My commission expires 8-15-55

PLUGGING
FILE SEC-27T-21-R-724
BOOK PAGE 76 LINE 33

GROUP EXPLORATION CO.

BOX 218
STERLING, KANSAS

WELL LOG - - - - - GREGG #1

Location - NW/4 NW/4 NW/4 Section 27-21-7, Rice County, Ks.

Owner - Robert G. Neill
Rotary Drilling Contractor - Group Exploration Company
Cable Tools Contractor -

Commenced - 12-28-52
Completed - 1-7-53 (w/r)
 (w/c.t.)

Total Depth - 3397' (w/r)
 (w/c.t.)

LOG

0- 60	Sand
60- 825	Shale
825-1290	Shale and Lime
1290-1490	Lime
1490-1840	Lime and Shale
1840-1995	Shale and Shells
1995-2145	Shale and Lime
2145-2295	Shale
2295-2445	Shale and Shells
2445-2480	Shale
2480-2670	Lime
2670-2965	Lime and Shale
2965-3290	Lime
3290-3380	Shale and Lime
3380-3392	Shale
3392-3397	Conglomerate

Top of Cong 11 - 3380

Top of Conglomerate	
3380-3397	
3397-3400	Hard Rock
3400-3450	Chat.
3450-3455	Lime T.D.

CASING RECORD

113' of 8-5/8" Surface Pipe
Cemented with 90 Sacks Cement

3401' of 5 1/2" O. D. Casing
set at ~~3380~~ 3380
Cemented with 40 Sacks Cement

PRODUCTION:

STATE OF KANSAS
FEB 2
CONSERVATION DIVISION
Wichita, Kansas

PLUGGING
FILE SEC 27 T 21 R 7W
BOOK 76 LINE 32