

Rec'd
9-25-83

STATE OF KANSAS
STATE CORPORATION COMMISSION
200 Colorado Derby Bldg.
Wichita, Kansas 67202


Form CP-4
Rev. 12-15-80

15-145-21071-0000

WELL PLUGGING RECORD

Give All Information Completely
Make Required Affidavit

COUNTY Pawnee SEC. 2 TWP. 23S RGE. 17W ~~EW~~
Location as in quarters or footage from lines:
E2 E2 NW

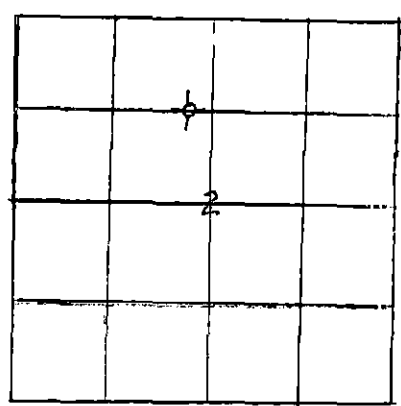

Locate Well
correctly on above
Section Platt.

Lease Owner Alpine Drilling Co., Inc.
Lease Name Boyd Well No. 1
Office Address 200 E. First, Suite 500, Wichita, KS 67202
Character of Well (Completed as Oil, Gas or Dry Hole): Dry Hole
Date Well Completed 9-25-83
Application for plugging filed 9-25-83
Plugging commenced 9-25-83
Plugging completed 9-25-83
Reason for abandonment of well or producing formation _____

Was permission obtained from the Conservation Division or it's
Agent's before plugging was commenced? yes

Name of Conservation Agent who supervised plugging of this well R. Lacey
Producing formation _____ Depth to top _____ bottom _____ T.D. 4258
Show depth and thickness of all water, oil and gas formations.

OIL, GAS OR WATER RECORDS Casing Record

| Formation | Content | From | To | Size | Put in | Pulled Out |
|-----------|---|------|-----|--------|--------|------------|
| Surface | shale | 0 | 365 | 8-5/8" | 362 | none |
| | cemented with 275 sx common, 2% gel, 3% cc, plug down at 6:30 p.m. by Allied; 9-18-83; cement did circ. | | | | | |

Describe in detail the manner in which the well was plugged, indicating where the mud fluid was placed and the method or methods used in introducing it into the hold. If cement or other plugs were used, state the character of same and depth placed, from _____ feet to _____ feet for each plug set.

Plugged as follows:
50 sx @ 1110'
50 sx @ 420'
10 sx @ 40'
10 sx in rat hole; job completed at 7 a.m. 9-25-83 by Allied
State Pluggger R. Lacey

(If additional description is necessary, use BACK of this sheet)
Name of Plugging Contractor J. W. Drilling Co., Inc.

STATE OF KANSAS COUNTY OF SEDGWICK, ss.
Jon T. Williams, Jr. (employee of owner) or (owner or operator) of the above-described well, being first duly sworn on oath, says: That I have knowledge of the facts, statements, and matters herein contained and the log of the above-described well as filed and that the same are true and correct. So help me God.

(Signature) [Signature]
200 E. First, Suite 500, Wichita, KS
(Address)



TO before me this 25th day of September, 19 83

Geraldine Stewart
Notary Public.

My Commission expires: January 14, 1985