

15-145-01122-0000


COPY - CORRECTED LOCATION

STATE OF KANSAS
STATE CORPORATION COMMISSION

Form CP-4

Give All Information Completely
Make Required Affidavit
Mail or Deliver Report to:
Conservation Division
State Corporation Commission
211 No. Broadway
Wichita, Kansas

WELL PLUGGING RECORD

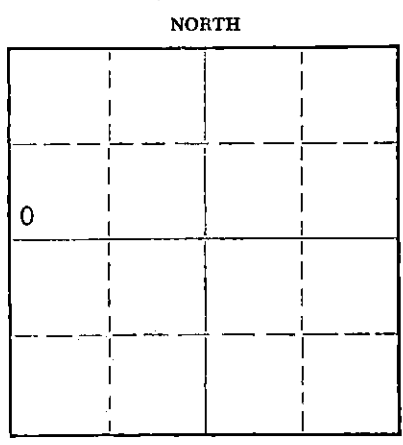

Locate well correctly on above
Section Plat

Pawnee County, Sec. 2 Twp. 23 Rge. (E) 17 (W)
 Location as "NE/CNW/SW" or footage from lines SW SW NW
 Lease Owner Colorado Oil Company
 Lease Name Boyd Well No. 2
 Office Address 915 Union Natl. Bldg., Wichita, Kansas
 Character of Well (completed as Oil, Gas or Dry Hole) Oil
 Date well completed May 25 19 55
 Application for plugging filed January 24 19 69
 Application for plugging approved January 27 19 69
 Plugging commenced March 1 19 69
 Plugging completed March 20 19 69
 Reason for abandonment of well or producing formation Depleted

If a producing well is abandoned, date of last production December 19 64
 Was permission obtained from the Conservation Division or its agents before plugging was commenced? Yes

Name of Conservation Agent who supervised plugging of this well Leo Massey
 Producing formation Congl. Chert Depth to top 4163 Bottom Total Depth of Well 4270 Feet
 Show depth and thickness of all water, oil and gas formations.

OIL, GAS OR WATER RECORDS

CASING RECORD

FORMATION	CONTENT	FROM	TO	SIZE	PUT IN	PULLED OUT
				8-5/8"	242	None
				5-1/2"	4269'	2207'

Describe in detail the manner in which the well was plugged, indicating where the mud fluid was placed and the method or methods used in introducing it into the hole. If cement or other plugs were used, state the character of same and depth placed, from feet to feet for each plug set.

Checked hole to 4236', rigged up on 5-1/2" casing.
 Ran sand to 4160', dumped 5 sacks cement. Had the hole loaded, shot pipe @ 2498', 3407', 3312', Allied spotted 60 bbls. of oil, shot pipe @ 3120', 3023', 2929', 2834' 2608', 2420', 2295' & 2195'. Worked pipe loose & pulled 70 joints. Pumped 20 sacks mud, 5 sacks hulls & 100 sacks of cement.

PLUGGING COMPLETE.

RECEIVED
 STATE CORPORATION COMMISSION
 APR 17 1969
 CONSERVATION DIVISION
 Wichita, Kansas

(If additional description is necessary, use BACK of this sheet)

Name of Plugging Contractor Knight Casing Pulling Co., Inc.
 Address Chase, Kansas

STATE OF Kansas, COUNTY OF Sedgwick, ss.

Bill K. Henrichs (employee of owner) or (owner or operator) of the above-described well, being first duly sworn on oath, says: That I have knowledge of the facts, statements, and matters herein contained and the log of the above-described well as filed and that the same are true and correct. So help me God.

(Signature) Bill K. Henrichs *Bill K. Henrichs*
 915 Union Natl. Bldg., Wichita, Kansas 67202
 (Address)

SUBSCRIBED AND SWORN to before me this 16th day of April, 19 69

My commission expires February 19, 1973

Betty J. McElwain
 Betty J. McElwain Notary Public.

RECEIVED
 STATE CORPORATION COMMISSION
 JAN 27 1969
 CONSERVATION DIVISION
 Wichita, Kansas

15-145-61122-000

DRILLERS LOG

Boyd Well No. 2
 Loc: SW SW NW
 Sec: 2-23-17
 Pawnee County, Kansas
 Company: Colorado Oil & Gas Corporation

Comm: 5-7-55
 Comp: 5-20-55
 Rotary Total Depth: 4270'
 Casing: 8-5/8" set @ 241'.
 5-1/2" set @ 4269'.

0	35	Sand & Clay.	
35	90	Sand & Shale.	
90	242	Shale & Shells.	8-5/8" surface casing
242	400	Shale.	set @ 241' cemented w/
400	520	Red Bed.	175 sacks cement and
520	610	Sand.	200 lbs. calcium chloride.
610	1120	Shale & Shells.	
1120	1160	Anhydrite.	
1160	1890	Shale & Shells.	
1890	1938	Shale.	
1938	2100	Lime.	
2100	2255	Lime & Sand streaks.	
2255	2365	Lime.	
2365	2450	Lime & Shale.	
2450	2470	Lime.	
2470	3000	Shale & Lime.	
3000	3145	Brown Lime.	
3145	3330	Lime & Shale.	
3330	3640	Lime.	
3640	3735	Lime & Shale.	
3735	4130	Lime.	
4130	4165	Lime & Shale.	
4165	4265	Chert & Lime.	
4265	4270	Chert.	
4270		Total Rotary Depth:	5-1/2" casing set @ 4269' w/ 175 sacks cement.

I certify that this is the true and correct copy of
 the above log, to the best of my knowledge.

W. H. Forbes

Subscribed and sworn to before me this 25th day of
 May, 1955.

Raymond P. Fisher

My Commission Expires: 6-25-55