


WELL PLUGGING RECORD

Give All Information Completely  
Make Required Affidavit  
Mail or Deliver Report to:  
Conservation Division  
State Corporation Commission  
800 Bitting Building  
Wichita, Kansas

NORTH

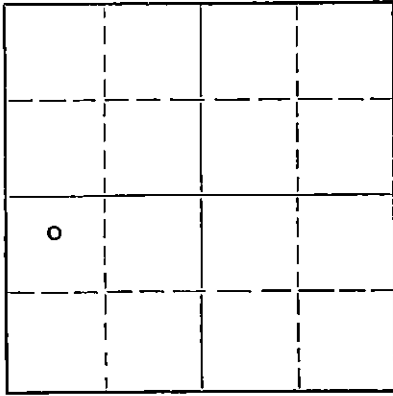

Locate well correctly on above Section Plat

Pawnee County. Sec. 1 Twp. 23 Rge. 17 (E) (W)  
Location as "NE/CNW/SW" or footage from lines NW NW SW  
Lease Owner Hilton Drilling Company, Inc.  
Lease Name L. J. Schartz "B" Well No. 1  
Office Address 2421 Tenth Street, Great Bend, Kansas  
Character of Well (completed as Oil, Gas or Dry Hole) Dry Hole  
Date well completed February 26, 1956  
Application for plugging filed March 9, 1956  
Application for plugging approved March 12, 1956  
Plugging commenced March 10, 1956  
Plugging completed March 14, 1956  
Reason for abandonment of well or producing formation Dry

If a producing well is abandoned, date of last production \_\_\_\_\_ 19\_\_\_\_  
Was permission obtained from the Conservation Division or its agents before plugging was commenced? Yes

Name of Conservation Agent who supervised plugging of this well Russell Brundage  
Producing formation \_\_\_\_\_ Depth to top \_\_\_\_\_ Bottom \_\_\_\_\_ Total Depth of Well 4393 Feet  
Show depth and thickness of all water, oil and gas formations.

OIL, GAS OR WATER RECORDS

CASING RECORD

FORMATION	CONTENT	FROM	TO	SIZE	PUT IN	PULLED OUT
		0	249	8-5/8"	249	None
		249	4404	5-1/2"	4404	3211

Describe in detail the manner in which the well was plugged, indicating where the mud fluid was placed and the method or methods used in introducing it into the hole. If cement or other plugs were used, state the character of same and depth placed, from \_\_\_\_\_ feet to \_\_\_\_\_ feet for each plug set.

Sand back to 4115', dumped in 5 sacks cement.  
Mud to 249', put in rock bridge to 245', dumped 20 sacks cement, mud to 35', put in rock bridge, dumped 10 sacks cement to base of cellar

(If additional description is necessary, use BACK of this sheet)  
Name of Plugging Contractor Ace Pipe Pulling Company  
Address Great Bend, Kansas

STATE OF KANSAS, COUNTY OF BARTON, ss.  
Henry Peacock, Secretary (employee of owner) or (owner or operator) of the above-described well, being first duly sworn on oath, says: That I have knowledge of the facts, statements, and matters herein contained and the log of the above-described well as filed and that the same are true and correct. So help me God.

(Signature) Henry Peacock  
Great Bend, Kansas  
(Address)

SUBSCRIBED AND SWORN to before me this 15th day of March, 1956

Mildred Hobbie  
Notary Public.

My commission expires \_\_\_\_\_

24-7366-5 3-53-20M

MILDRED HOBBIER  
MY COMMISSION EXPIRES MARCH 6, 1958  
STATE OF KANSAS

**PLUGGING**  
PLK SEC 1 T 23 R 17W  
BOOK PAGE 44 LINE 29

3-16-56