


STATE OF KANSAS
STATE CORPORATION COMMISSION

WELL PLUGGING RECORD 15-145-00363-0000

Give All Information Completely
Make Required Affidavit
Mail or Deliver Report to:
Conservation Division
State Corporation Commission
800 Bitting Building
Wichita, Kansas

Pawnee County, Sec. 1 Twp. 23 Rge. 17 (X) (W)
Location as "NE/CNW/SW" or footage from lines NW NW SW
Lease Owner Colorado Oil & Gas Corporation
Lease Name Schartz Well No. 1
Office Address Denver, Colorado
Character of Well (completed as Oil, Gas or Dry Hole) Dry Hole
Date well completed 3-29 19 55
Application for plugging filed 3-29 19 55
Application for plugging approved 3-29 19 55
Plugging commenced 11:30 P. M. 3-29 19 55
Plugging completed 1:30 A. M. 3-30 19 55
Reason for abandonment of well or producing formation Dry Hole

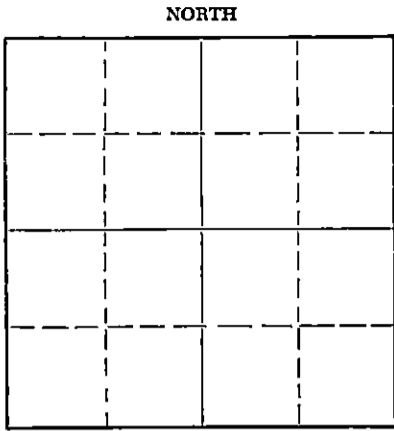

Locate well correctly on above Section Plat

If a producing well is abandoned, date of last production 19
Was permission obtained from the Conservation Division or its agents before plugging was commenced? Yes Phone

Name of Conservation Agent who supervised plugging of this well M. A. Rives
Producing formation Depth to top Bottom Total Depth of Well 4395 Feet
Show depth and thickness of all water, oil and gas formations.

OIL, GAS OR WATER RECORDS CASING RECORD

FORMATION	CONTENT	FROM	TO	SIZE	PUT IN	PULLED OUT
				8 5/8	250	None

Describe in detail the manner in which the well was plugged, indicating where the mud fluid was placed and the method or methods used in introducing it into the hole. If cement or other plugs were used, state the character of same and depth placed, from feet to feet for each plug set.

Set plug @ 250' with 20 sacks cement through drill pipe.
Filled hole with Heavy Rotary Mud to 35'.
Set plug @ 35' with 10 sacks cement.
Cement to bottom cellar.

(If additional description is necessary, use BACK of this sheet)

Name of Plugging Contractor Honaker Drilg., Inc.
Address 2008 Lakin, Great Bend, Kansas

STATE OF Kansas, COUNTY OF Barton, ss.
R. I. Ellison (employee of owner) or (owner or operator) of the above-described well, being first duly sworn on oath, says: That I have knowledge of the facts, statements, and methods contained and the log of the above-described well as filed and that the same are true and correct. So help me God.

(Signature) R. I. Ellison
2008 Lakin, Great Bend, Kansas
(Address)

SUBSCRIBED AND SWORN TO before me this 5th day of April 19 55
Notary Public.

My commission expires 6-25-55

24-7966-5 3-53-20M

RECEIVED
STATE CORPORATION COMMISSION

PLUGGING
FILE SEC 1 T23 R17W
BOOK PAGE 108 LINE 71

1955 APR 7 4-7-55
CONSERVATION DIVISION
Wichita, Kansas

DRILLERS LOG

15-45-003630000

Schartz Well No. 1

~~XXXXXXXXXXXXXXXXXXXX~~

Loc: NW NW SW

Sec: 1-23-17

Pawnee County, Kansas

Contractor: Honaker Drlg., Inc.

Company: Colorado Oil & Gas Corporation

Comm: 3-12-55

Comp: 3-30-55

Elevation: 2073 D.F.

Total Depth: 3295'

Casing: 8-5/8" at 249'

0	45	Sand & Clay.	
45	75	Sand.	
75	420	Shale & Shells.	8-5/8" casing cemented
420	520	Red Bed.	@ 249' with 175 sacks
520	580	Sand & Shells.	cement & 200# calcium
580	1090	Red Bed, Shale & Shells.	chloride.
1090	1135	Anhydrite.	
1135	1880	Shale & Shells.	
1880	2070	Shale & Lime.	
2070	2160	Lime & Shale.	
2160	2400	Lime.	
2400	3335	Shale & Lime.	
3335	3370	Shale.	
3370	3420	Lime & Shale.	
3420	3560	Shale & Lime.	
3560	3595	Lime.	
3595	3600	Shale.	
3600	3603	Lime.	
3603	3715	Lime & Shale.	
3715	4120	Lime.	
4120	4170	Lime & Shale.	
4170	4210	Lime.	
4210	4240	Conglomerate.	
4240	4255	Lime & Shale.	
4255	4355	Lime & Shale.	
4355	4395	Lime.	
4395	4395	Total Rotary Depth.	D & A.

I certify that this is the true and correct copy of the above log, to the best of my knowledge.

H. L. Davis

Subscribed and sworn to before me this 6th day of April, 1955.

R. D. Honaker
Notary Public

My Commission Expires: 6-25-55

PLUGGING
BOOK PAGE 108 LINE 11

CONCERN
White