


STATE OF KANSAS
STATE CORPORATION COMMISSION

Give All Information Completely
Make Required Affidavit
Mail or Deliver Report to:
Conservation Division
State Corporation Commission
800 Bittling Building
Wichita, Kansas

WELL PLUGGING RECORD
OR
FORMATION PLUGGING RECORD

Strike out upper line
when reporting plug-
ging off formations.

NORTH

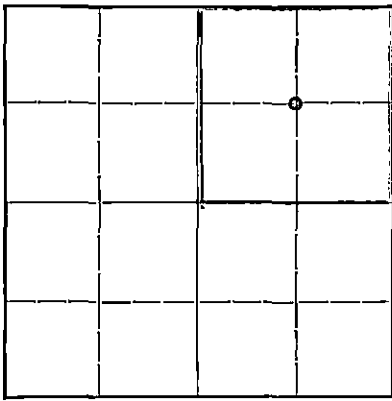

Locate well correctly on above
Section Plat

Rice County. Sec. 6 Twp. 21S Rge. 7 (W)
Location as "NE 1/4 NW 1/4 SW 1/4" or footage from lines... C NE 1/4
Lease Owner: Carlock & Dufton
Lease Name: Oden Well No. 1
Office Address: 600 Ellis-Singleton Bldg., Wichita, Kansas.
Character of Well (completed as Oil, Gas or Dry Hole) Dry Hole
Date, well completed 5-15-41 19
Application for plugging filed May 20th 1941 19
Application for plugging approved May 21-1941 19
Plugging Commenced May 17th-1941 19
Plugging Completed May 18th-1941 19
Reason for abandonment of well or producing formation Dry
If a producing well is abandoned, date of last production 19
Was permission obtained from the Conservation Division or its agents before plugging was com-
menced? Yes

Name of Conservation Agent who supervised plugging of this well Ruel Durkee
Producing formation Conglomerate Depth to top 3326 1/2 Bottom Total Depth of Well 3366 Feet
Show depth and thickness of all water, oil and gas formations.

OIL, GAS OR WATER RECORDS

CASING RECORD

Formation	Content	From	To	Size	Put In	Pulled Out

Describe in detail the manner in which the well was plugged, indicating where the mud fluid was placed and the method or methods used in introducing it into the hole. If cement or other plugs were used, state the character of same and depth placed, from feet to feet for each plug set.

Total Depth 3366'
5-1/2" Casing at 3326'
8-5/8" Casing at 120'
(6 sacks) Plug - Mud to 3350'; cement from 3350' to 3310'
(10 sacks) Plug - Mud from 3310' to 200'; cement from 200' to 180'
(6 sacks) Cap - Mud from 180' to 14'; Cement from 14' to 6'

pd
5/24/41
na

PLUGGING
FILE SEC 6-21-R 7U
BOOK PAGE 138 LINE 12

WICHITA, KANSAS
MAY 27 1941
STATE CORP. DIV.

5-27-41

(If additional description is necessary, use BACK of this sheet)

Correspondence regarding this well should be addressed to C. L. Carlock
Address 600 Ellis-Singleton Bldg., Wichita, Kansas.

STATE OF Kansas, COUNTY OF Sedgwick, ss.
C. L. Carlock (owner or operator) of the above-described well,
being first duly sworn on oath, says: That I have knowledge of the facts, statements, and matters herein contained and the log of the above-described well as filed and that the same are true and correct. So help me God.

(Signature) *[Signature]*

600 Ellis Singleton Bldg., Wichita, Ks.
(Address)

SUBSCRIBED AND SWORN to before me this 23rd day of May, 1941

My commission expires June 27th 1944

[Signature]
Notary Public.

15.159.03379.0000

Chester L. Carlock, lease-owner

Sec. 6, T 21 S, R 7 W.

Open No. 1 well

C. NE 1/4

Inglis & Parker, Contractors

County - Rice

Total Depth Rotary - 3326-1/2'

Elevation

Comm. Rotary - April 27, 1941.

Production

Comp. Rotary - May 10, 1941.

Casing - 12675' - 6-1/4"

3325'3" - 5-1/2"

(Figures indicate bottom of formations)

Sand and shale	50'
Shale and shells	129
Red bed shale	180
Shale and shells	680
Shale and salt	1150
Lime shells and shale	1400
Shale and lime	1625
Shale and shells	1800
Shale	1910
Shale and shells	2050
Shale and lime	2170
Shale	2255
Shale and lime	2315
Shale and lime shells	2400
Lime and shale	2900
Lime	3205
Shale and lime	3306
Shale	3318
Lime	3326-1/2 (TD Rotary)

We hereby certify that the above is a true and correct log of the well above mentioned in so far as the rotary hole is concerned.

Inglis & Parker

Charles Parker

PLUGGING
FILE NO. 6-21-R-74
BOOK PAGE 138 LINE 12

