


STATE OF KANSAS
STATE CORPORATION COMMISSION

WELL PLUGGING RECORD

Give All Information Completely
Make Required Affidavit
Mail or Deliver Report to:
Conservation Division
State Corporation Commission
800 Bittling Building
Wichita, Kansas

Rice County. Sec. 6 Twp. 21 Rge. (E) 7 (W)
Location as "NE/CNW $\frac{1}{4}$ /SW $\frac{1}{4}$ " or footage from lines NW NE SE
Lease Owner Thos. H. Allan & J. L. Chew
Lease Name Hughes Well No. 1
Office Address 1221 Union National Bank Bldg., Wichita 2, Kansas
Character of Well (completed as Oil, Gas or Dry Hole) Dry Hole
Date well completed July 1 19 52
Application for plugging filed July 1 19 52
Application for plugging approved July 1 19 52
Plugging commenced July 1 19 52
Plugging completed July 1 19 52
Reason for abandonment of well or producing formation Dry Hole

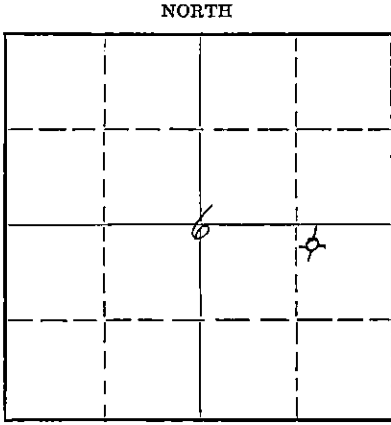

Locate well correctly on above
Section Plat

If a producing well is abandoned, date of last production 19
Was permission obtained from the Conservation Division or its agents before plugging was commenced? Yes

Name of Conservation Agent who supervised plugging of this well Ruel Durkee
Producing formation Conglomerate Depth to top 3335' Bottom 3362' Total Depth of Well 3369 Feet
Show depth and thickness of all water, oil and gas formations.

OIL, GAS OR WATER RECORDS

CASING RECORD

Formation	Content	From	To	Size	Put In	Pulled Out
				8 5/8"	141'	None
				5 1/2"	3337'	2655'

Describe in detail the manner in which the well was plugged, indicating where the mud fluid was placed and the method or methods used in introducing it into the hole. If cement or other plugs were used, state the character of same and depth placed, from _____ feet to _____ feet for each plug set.

- 3369 - 3330 Heavy Mud
- 3330 - 3300 6 sacks of cement
- 3300 - 135 Heavy Rotary Mud
- 135 - 100 Rock Bridge and 15 sacks cement
- 100 - 30 Heavy Mud
- 30 - Surface Rock Bridge and 5 sacks cement

REG. FILE
STATE CORPORATION COMMISSION
JUL 9 1952
CONSERVATION DIVISION
WICHITA, KANSAS

Name of Plugging Contractor Thos. H. Allan
Address 1221 Union National Bank Bldg., Wichita 2, Kansas

STATE OF KANSAS, COUNTY OF SEDGWICK, ss.
Thos. H. Allan (employee of owner) or (owner or operator) of the above-described well,
being first duly sworn on oath, says: That I have knowledge of the facts, statements, and matters herein contained and the log of the above-described well as filed and that the same are true and correct. So help me God.

(Signature) Thos. H. Allan
1221 Union National Bank Bldg., Wichita 2, Kansas
(Address)

SUBSCRIBED AND SWORN TO before me this 8th day of July, 1952.

Ocie M Stewart
Notary Public.

My commission expires June 14, 1954

PLUGGING
FILE SEC 6 T 21 R 7 W
BOOK PAGE 29 LINE 3

141' of 8 5/8" = 130 sx
3337' of 5 1/2" = 75 sx
Pulled 2655'

ALLAN & CHEW #1 HUGHES
NW NE SE 6-21-7W
Rice County, Kansas
COMM: 6/14/52. COMPL: 7/1/52
CONTRACTOR: Tom Allan
ELEVATION: 1629 DF
1631 RB
I.P. D & A

Depth from Rotary Bushings.

- 0 - 22 Surface Soil
- 65 Sand & Coarse Gravel.
- 139 Red Beds
- 450 Red & Green Shale with Anhydrite Stringers
- 700 Gray shale
- 1010 Salt & Shale
- 1220 Shale & Anhydrite
- 1250 Shale
- 1310 Lime & Shale
- 1350 Lime
- 1410 Lime & Shale
- 1440 Lime & Chert
- 1810 Lime & Shale
- 1840 Lime
- 1940 Shale
- 2000 Lime & Shale
- 2060 Red & Gray Shale
- 2560 Lime & Shale
- 2640 Lime & Chert
- 2750 Lime with Shale Breaks
- 2780 Lime & Shale
- 2875 Sand & Shale
- 2879 Dark Brown Lime
- 2900 Sand & Shale
- 3015 Lime & Shale
- 3025 Soft Oolitic Lime
- 3238 Lime & Shale
- 3306 Shale & Shells
- 3337 Red & Green Shale with Orange Chert
- 3339 (RTD) Varicolored chert
- 3339 RB = 3337 DF
- 3347 DF Varicolored Chert with show of Oil
- 3362 DF Red & Green & Varicolored Chert
- 3366 DF Weathered white Chert & Tripoli
- 3369 DF (TD) Red & Green Shale

TESTING:
Bail 8 gal. Oil & 8 gal. Water
Per hour.

I certify that the above is a true and correct copy of the well log on the above test.

Tom Allan

Subscribed and sworn to before me this 7th day of July, 1952

Osie M. Stewart
Notary Public

My Commission expires June 14, 1954

FORMATIONS:

- Lansing 2898 DF
- Sooy 3335 DF
- Mississippian 3362 DF

RECEIVED
STATE COMMISSION
JUL - 9 1952
CONSERVATION DIVISION
Wichita, Kansas

LOGGING
FILE NO. 672 R 40
BOOK PAGE 29