

STATE OF KANSAS
STATE CORPORATION COMMISSION

WELL PLUGGING RECORD

OR

FORMATION PLUGGING RECORD

Strike out upper line
when reporting plug-
ging of formations.

Give All Information Completely
Make Required Affidavit
Mail or Deliver Report to:
Conservation Division
State Corporation Commission
800 Bittling Building
Wichita, Kansas

RICE

County. Sec. 14 Twp. 21 Rge. 7 (E) (W) est

Location as "NE¹/₄NW¹/₄SW¹/₄" or footage from lines 330' from N. and W. lines

Lease Owner. KIRK D. HOLLAND

Lease Name. O'CONNELL

Well No. #1

Office Address. 624 S. Michigan Avenue, Chicago, Illinois.

Character of Well (completed as Oil, ~~Water or Gas~~)

Date, well completed. November 19, 1936 193

Application for plugging filed. September 10, 1941 193

Application for plugging approved. September 12, 1941 193


Plugging Commenced. September 19, 1941 193

Plugging Completed. September 20, 1941 193

Reason for abandonment of well or producing formation. No oil.

If a producing well is abandoned, date of last production. 193

Was permission obtained from the Conservation Division or its agents before plugging was com-
menced? Yes.

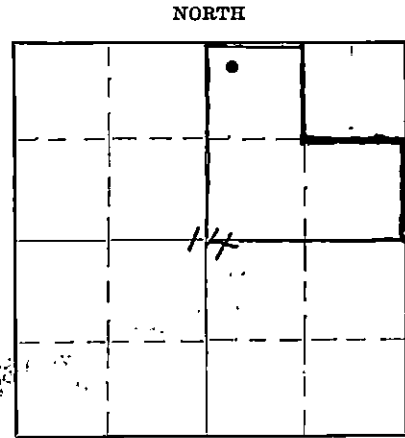

Locate well correctly on above
Section Plat

Name of Conservation Agent who supervised plugging of this well

Producing formation. Conglomerate Depth to top. 3365' Bottom. 3384' Total Depth of Well. 3384' Feet

Show depth and thickness of all water, oil and gas formations.

OIL, GAS OR WATER RECORDS


CASING RECORD

Formation	Content	From	To	Size	Put In	Pulled Out
Drilled with rotary				7 O.D.	3365'	1700'

Describe in detail the manner in which the well was plugged, indicating where the mud fluid was placed and the method or methods used in introducing it into the hole. If cement or other plugs were used, state the character of same and depth placed, from _____ feet to _____ feet for each plug set.

Cement at bottom and top of hole. Mud in between.

FILE 14 21 9 700 pd
BOOK PAGE 7 LINE 18
10/21/41

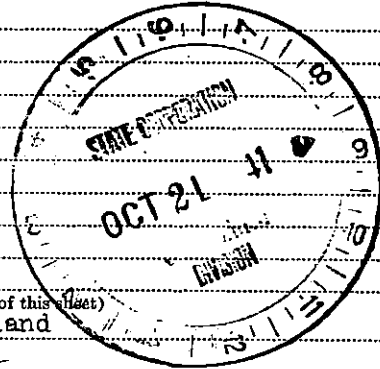

(If additional description is necessary, use BACK of this sheet)

Correspondence regarding this well should be addressed to. Kirk D. Holland
Address. 624 S. Michigan Avenue, Chicago, Ill.

STATE OF ILLINOIS, COUNTY OF COOK, ss.

KIRK D. HOLLAND (employee of owner) or (owner or operator) of the above-described well,

being first duly sworn on oath, says: That I have knowledge of the facts, statements, and matters herein contained and the log of the above-described well as filed and that the same are true and correct. So help me God.

(Signature) Kirk D. Holland

624 S. Michigan Avenue, Chicago, Ill.
(Address)

SUBSCRIBED AND SWORN to before me this 20th day of October, 1941.

Margaret C. Johnson
Notary Public.

My commission expires. May 17, 1943.

15.159.05421.0000

T. M. DEAL OIL & REFINING COMPANY,
No. 1 O'Connell

NW NW NE
Sec. 14-21S-7W
Rice County

Elevation: 1601
Total Depth: 3384'
Commenced: 10-6-36
Completed: 11-19-36
I. P.: 590 Bbls.

Casing Record:
12 1/2" - 130'
7 OD - 3365'

Figures indicate bottom of formations.

shale & sandstone	120
lime	130
lime & shale	177
shale	470
shale & shells	1267
lime & shale	1411
lime & shells	1453
lime	1530
lime & shale	1706
broken lime	1780
lime & shale	1934
shale & shells	2044
broken lime	2144
lime & shale	2242
shale & shells	2312
broken lime	2334
lime	2722
sandy lime	2840
lime	2867
red bed	2972
lime	3113
sandy lime	3121
lime & shale	3141
sandstone	3150
lime	3161
lime & shale	3199
lime	3225
shale & lime	3359 1/2
red rock	3362
conglomerate	3384 - 60
TOTAL DEPTH	3384

Rotary to 3365', cable tools to 3384'.

16

FILE	14 21 7W
BOOK	7 - NE - 68

