

STATE OF KANSAS
STATE CORPORATION COMMISSION

Give All Information Completely
Make Required Affidavit
Mail or Deliver Report to:
Conservation Division
State Corporation Commission
211 No. Broadway
Wichita, Kansas


15-009-03368-00-00

WELL PLUGGING RECORD

Barton County, Sec. 24 Twp. 16S Rge. 12 (E) (W)

Location as "NE/CNW/SW" or footage from lines C N/2 NW NW
Lease Owner Gulf Oil Corporation
Lease Name F. Hofmeister Well No. 1
Office Address Box 661, Tulsa, Oklahoma
Character of Well (completed as Oil, Gas or Dry Hole) Oil
Date well completed 8-6 19 57
Application for plugging filed 3-19 19 57
Application for plugging approved 3-20 19 57
Plugging commenced 4-10 19 57
Plugging completed 4-15 19 57
Reason for abandonment of well or producing formation Well operating below its economic limit.
If a producing well is abandoned, date of last production 2-15 19 57
Was permission obtained from the Conservation Division or its agents before plugging was commenced? Yes

NORTH

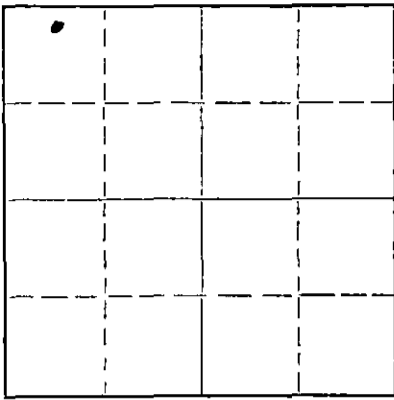

Locate well correctly on above Section Plat

Name of Conservation Agent who supervised plugging of this well R. M. Brundage
Producing formation Arbuckle Depth to top 3347' Bottom 3359' Total Depth of Well 3359 Feet
Show depth and thickness of all water, oil and gas formations.

OIL, GAS OR WATER RECORDS

CASING RECORD

FORMATION	CONTENT	FROM	TO	SIZE	PUT IN	PULLED OUT
				8-5/8"	409	- 0 -
				5-1/2"	3348'	2598'

Describe in detail the manner in which the well was plugged, indicating where the mud fluid was placed and the method or methods used in introducing it into the hole. If cement or other plugs were used, state the character of same and depth placed, from _____ feet to _____ feet for each plug set.
Filled with sand from 3359-35'. Dumped 5 sacks cement at 3335'. Filled with mud to 330'. Placed rock bridge and dumped 20 sacks cement at 330'. Filled with mud to 20', placed rock bridge and capped with 5 sacks cement filling hole into cellar.

(If additional description is necessary, use BACK of this sheet)

Name of Plugging Contractor Morgan Well Plugging Service
Address 102 W. 18th, Hutchinson, Kansas

STATE OF Kansas, COUNTY OF Sedgwick, ss.
Thomas A. Trax (employee of owner) of Gulf Oil Corporation of the above-described well, being first duly sworn on oath, says: That I have knowledge of the facts, statements, and matters herein contained and the log of the above-described well as filed and that the same are true and correct. So help me God.

(Signature) [Signature]
Thomas A. Trax - Asst. Zone Supt. of Prod.
Box 2233, Wichita, Kansas
(Address)

SUBSCRIBED AND SWORN TO before me this 16th day of April, 19 57

My commission expires 2-1-59

Ray W. Rousner Notary Public.

RECEIVED
STATE CORPORATION COMMISSION

APR 19 1957

CONSERVATION DIVISION
Wichita, Kansas

JRM:BJT

PLUGGING
FILE SEC 24 T. 16 R. 12w
BOOK PAGE 149 LINE 19

419-57

15-009-03368-00-00

GULF OIL CORPORATION

HOFMEISTER # 1

CENTER OF N/2, NW NW
SECTION 24-16S-12W
BARTON COUNTY, KANSAS

FROM	TO	FORMATION
0	35	Clay
35	105	Shale & Shells
105	150	Sand & Shale
150	370	Shale & Red Bed
8-5/8" OD Casing cemented @ 390'		
370	785	Shale & Shells
785	812	Anhydrite
812	1155	Shale & Shells
1155	1200	Lime
1200	1440	Shale, Shells & Salt
1440	1490	Shale & Shells
1490	1560	Lime
1560	1620	Lime & Shale
1620	2150	Lime
2150	2225	Shale & Shells
2225	2319	Broken Lime
2319	2360	Shale
2360	2380	Lime
2380	2505	Shale
2505	2655	Broken Lime
2655	2745	Shale & Lime
2745	2980	Lime
2980	3010	Lime & Shale
3010	3347	Lime
3347	3350	Cored Lime
5-1/2" OD Casing cemented @ 3345'		
3350	3355	Arbuckle Lime
Total Depth	3355 FT.	

PLUGGING
FILE SEC 24 T 16 R 12W
BOOK PAGE 149 LINE 19

RECEIVED
