

STATE OF KANSAS
STATE CORPORATION COMMISSION


Give All Information Completely
Make Required Affidavit
Mail or Deliver Report to:
Conservation Division
State Corporation Commission
800 Biting Building
Wichita, Kansas

OR

FORMATION PLUGGING RECORD

Strike out upper line
when reporting plugging
of formations.

Barton County, Sec. 24, Twp. 16 Rge. 12 (W)
Location as "NE $\frac{1}{4}$ NW $\frac{1}{4}$ SW $\frac{1}{4}$ " or footage from lines CE $\frac{1}{2}$ E $\frac{1}{2}$ SE
Lease Owner National Cooperative Refinery Association
Lease Name P. Dolechek Well No. 12
Office Address 820 Union National Bank Building, Wichita, Kansas
Character of Well (completed as Oil, Gas or Dry Hole) Dry Hole

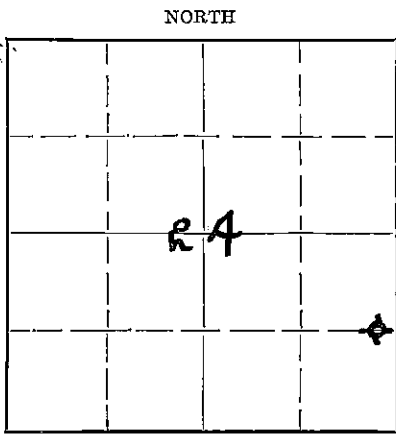

Locate well correctly on above
Section Plat

Date well completed May 1, 19.50
Application for plugging filed May 9, 19.50
Application for plugging approved May 10, 19.50
Plugging commenced May 23, 19.50
Plugging completed May 25, 19.50
Reason for abandonment of well or producing formation Dry Hole

Name of Conservation Agent who supervised plugging of this well Durkee
Producing formation - Depth to top - Bottom - Total Depth of Well 3384 Feet
Show depth and thickness of all water, oil and gas formations.

OIL, GAS OR WATER RECORDS

CASING RECORD

Formation	Content	From	To	Size	Put In	Pulled Out
				8 5/8"	261	None
				5 1/2"	None	None

Describe in detail the manner in which the well was plugged, indicating where the mud fluid was placed and the method or methods used in introducing it into the hole. If cement or other plugs were used, state the character of same and depth placed, from _____ feet to _____ feet for each plug set.
Dumped 5 sacks cement on bottom, mudded to 250', put in plug (rock bridge) and dumped 15 sacks cement. Mudded to 30', put in plug and 10 sacks cement. Filled to top of surface pipe (base of cellar). Plugging completed.

6-7-50

JUN 7 1950

(If additional description is necessary, use BACK of this sheet)

Correspondence regarding this well should be addressed to National Cooperative Refinery Association
Address 820 Union National Bank Building, Wichita, Kansas

STATE OF Kansas, COUNTY OF Sedgwick, ss.

(employee of owner) or (owner or operator) of the above-described well, being first duly sworn on oath, says: That I have knowledge of the facts, statements, and matters herein contained and the log of the above-described well as filed and that the same are true and correct. So help me God.

(Signature) James C. Hogwood
James C. Hogwood
820 Union National Bank Building, Wichita, Kans.
(Address)

SUBSCRIBED AND SWORN to before me this 6th day of June, 19.50

My commission expires February 20, 1953

I. A. Lange
Notary Public.

PLUGGING
FILE SEC 24 T 16 R 12W
BOOK PAGE 8 LINE 4

To CC

DRILLING LOG

To: National Cooperative Refinery Association,
Union National Bank Building
Wichita 2, Kansas

Lease: Paul Dolechek #12

County: Barton, Kansas
Section: 24-16S-12W
Location: Cen. E/2 E/2 SE/4

Rotary Total Depth: 3384'
Commenced: 5-11-50 Completed: 5-25-50
Casing: 8-5/8" @ 261' w/100 sacks cement
5-1/2" @ none - dry

Contractor: John Lindas Oil, Inc.
1316 Union National Bank Building
Wichita 2, Kansas

FIGURES INDICATE BOTTOM OF FORMATIONS

0	to	65	Surface Clay & Shell
65		165	Shale & Shells
165		255	Sand & Streaks of Shale
255		261	Red Bed & Shale
261		535	Shale & Sand
535		720	Red Bed & Shale
720		765	Red Bed
765		796	Anhydrite
796		1200	Shale & Shell
1200		1410	Shale & Salt
1410		1675	Broken Lime
1675		1733	Lime & Shale
1733		1810	Broken Lime
1810		1865	Sand
1865		1940	Lime & Shale
1940		2055	Shale & Lime
2055		2235	Lime & Shale
2235		2340	Shale & Lime Shells
2340		2565	Shale & Lime
2565		2700	Shale & Shells
2700		2785	Lime & Shale
2785		2830	Lime
2830		2870	Shale & Lime
2870		2935	Lime & Shale
2935		2990	Lime
2990		3075	Shale & Lime Shells
3075		3346	Lime
3346		3378	Lime & Sand
3378		3384	T. D. Lime

STATE OF KANSAS)
) SS
COUNTY OF SEDGWICK)

RECEIVED
JUN 2 X 1950
REGISTRATION
DIVISION

I, the undersigned, being duly sworn on oath, state that the above statement and log is true and correct record and log of the well drilled at the location above described.

JOHN LINDAS OIL, INC.

By Scott Stucky

Subscribed and sworn to before me this 31st day of May, 1950.

Catherine Dancy
Notary Public

My Commission Expires

PLUGGING
FILE SEC 24-16-12W
BOOK PAGE 8 LINE 4