


STATE OF KANSAS
STATE CORPORATION COMMISSION

Give All Information Completely
Make Required Affidavit
Mail or Deliver Report to:
Conservation Division
State Corporation Commission
211 No. Broadway
Wichita, Kansas

15-009-07023-00-00
WELL PLUGGING RECORD

NORTH

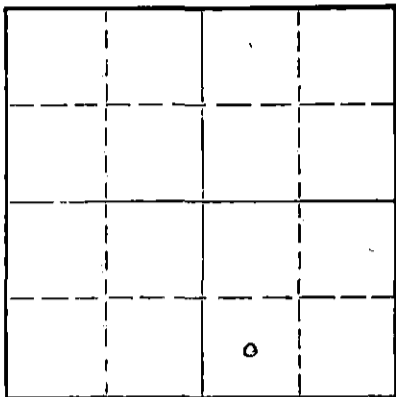

Locate well correctly on above
Section Plat

Barton County, Sec. 24 Twp. 16S Rge. 12W (E) (W)

Location as "NE/CNW/SE/SW" or footage from lines SW/SE/NE
Lease Owner M. J. Bove
Lease Name Dolechek Well No. 1
Office Address Russell, Kansas
Character of Well (completed as Oil, Gas or Dry Hole) Gas
Date well completed 10-26-53 19
Application for plugging filed 12-18-62 19
Application for plugging approved 12-20-62 19
Plugging commenced 12/27/62 19
Plugging completed 1/2/63 19
Reason for abandonment of well or producing formation Uneconomical

If a producing well is abandoned, date of last production Dec. 12, 1962 19
Was permission obtained from the Conservation Division or its agents before plugging was commenced? yes

Name of Conservation Agent who supervised plugging of this well Don Duron
Producing formation Regan Depth to top 3348 Bottom 3386 Total Depth of Well 3386 Feet
Show depth and thickness of all water, oil and gas formations.

OIL, GAS OR WATER RECORDS

CASING RECORD

| FORMATION | CONTENT | FROM | TO | SIZE | PUT IN | PULLED OUT |
|-----------|---------|------|------|-------|--------|------------|
| Regan | Oil | 3348 | 3386 | 5 1/2 | 3348 | 2684 |
| | | | | | | |
| | | | | | | |
| | | | | | | |
| | | | | | | |
| | | | | | | |

Describe in detail the manner in which the well was plugged, indicating where the mud fluid was placed and the method or methods used in introducing it into the hole. If cement or other plugs were used, state the character of same and depth placed, from _____ feet to _____ feet for each plug set.

with Bridge @ 225 ft. 10 ft. rock fill to surface/Redi Mix (3 yds Redi Mix)

RECEIVED
STATE CORPORATION COMMISSION

JAN 25 1963

CONSERVATION DIVISION
Wichita, Kansas

1-25-63

(If additional description is necessary, use BACK of this sheet)
Name of Plugging Contractor Central Pipe Pulling Co.
Address 1416 Coolidge Great Bend, Kansas

STATE OF Kansas, COUNTY OF Russell, ss.
E. T. Drube (employee of owner) or (owner or operator) of the above-described

well, being first duly sworn on oath, says: That I have knowledge of the facts, statements, and matters herein contained and the log of the above-described well as filed and that the same are true and correct. So help me God.

(Signature) *E. T. Drube*

Russell, Kansas
(Address)

SUBSCRIBED AND SWORN TO before me this 24th day of January, 1963

Ruth E. Miller

My commission expires January 5, 1965

Notary Public.



15-009-07023-00-00
 KANSAS WELL LOG BUREAU --- KANSAS GEOLOGICAL SOCIETY
 508 EAST MURDOCK - WICHITA, KANSAS


COMPANY **United Drilling, Inc.**

SEC. 24 T. 16 R. 12
 LOC. NW SE NE

FARM **Dolechek** NO. **1**

TOTAL DEPTH **3351**
 COMM. **10-18-53** COMP. **10-26-53**
 SHOT OR TREATED
 CONTRACTOR **United Drilling, Inc.**
 ISSUED

Barton COUNTY

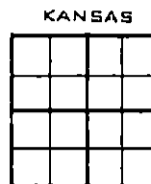

CASING **8 5/8" 194'**

20 10
 15 8
 12 6
 13 5

ELEVATION **1910' DF**

PRODUCTION **25 barrels**

FIGURES INDICATE BOTTOM OF FORMATIONS

| | |
|------|-------------------------|
| 75 | Sand |
| 255 | Sand, Shale and Red Bed |
| 775 | Anhydrite |
| 805 | Shale and Shells |
| 1190 | Sale, Shale and Shells |
| 1550 | Lime and Shale |
| 2783 | Lime |
| 2995 | Lime and Shale |
| 3175 | Lime |
| 3351 | Total Rotary Depth. |

RECEIVED
 STATE CORPORATION COMMISSION

FEB 27 1963

CONSERVATION DIVISION
 Wichita, Kansas

I certify that this is the true and correct copy of the above log, to the best of my knowledge.

Subscribed and sworn to before me this _____ day of _____ 1954.

 Notary Public

My Commission Expires:
