

Give All Information Completely  
Make Required Affidavit  
Mail or Deliver Report to:  
Conservation Division  
State Corporation Commission  
211 No. Broadway  
Wichita, Kansas

WELL PLUGGING RECORD 15-145-01148-0000

Pawnee County, Sec. 3 Twp. 23 Rge. (E) 17 (W)

Location as "NE/CNW/SW" or footage from lines SE NW NW

Lease Owner Clark Knight Drilling Company

Lease Name Hutchinson Well No. 8

Office Address 2433 Walnut Drive, Great Bend, Kansas

Character of Well (completed as Oil, Gas or Dry Hole) oil

Date well completed 19 62

Application for plugging filed 10-22 19 62

Application for plugging approved 19 62


Plugging commenced 11-12 19 62

Plugging completed 11-19 19 62

Reason for abandonment of well or producing formation well no longer profitable

If a producing well is abandoned, date of last production 19

Was permission obtained from the Conservation Division or its agents before plugging was commenced? yes

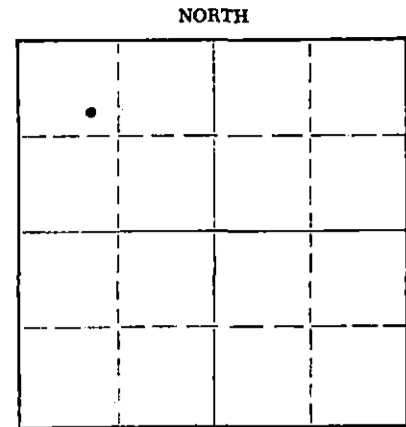

Locate well correctly on above Section Flat

Name of Conservation Agent who supervised plugging of this well Bill Lackamp

Producing formation Depth to top Bottom Total Depth of Well 4270 Feet

Show depth and thickness of all water, oil and gas formations.

OIL, GAS OR WATER RECORDS

CASING RECORD

FORMATION	CONTENT	FROM	TO	SIZE	PUT IN	PULLED OUT
				10 3/4"	180	none
				5 1/2"	4269	2716.91

Describe in detail the manner in which the well was plugged, indicating where the mud fluid was placed and the method or methods used in introducing it into the hole. If cement or other plugs were used, state the character of same and depth placed, from feet to feet for each plug set.

Plug back with sand to 4120' and set 10' rock bridge,  
dumped 5 sacks of cement. Filled hole with mud, pumped  
15 sacks of mud and 75 sacks of cement into surface pipe.  
Top of cement even with cellar floor.

RECEIVED  
STATE CORPORATION COMMISSION

MAR 1 1963

CONSERVATION DIVISION  
Wichita, Kansas

(If additional description is necessary, use BACK of this sheet)

Name of Plugging Contractor Pipe Pullers, Inc.  
Address Box 486, Ellinwood, Kansas

STATE OF Kansas, COUNTY OF Barton, ss.

(employee of owner) or (owner or operator) of the above-described well, being first duly sworn on oath, says: That I have knowledge of the facts, statements, and matters herein contained and the log of the above-described well as filed and that the same are true and correct. So help me God.

(Signature) *Sam Steer*  
Ellinwood, Kansas  
(Address)

SUBSCRIBED AND SWORN TO before me this 3rd day of December, 19 62

My commission expires February 10, 1963

*George A. Meyer*  
Notary Public




WELL LOG BUREAU—KANSAS GEOLOGICAL SOCIETY  
508 East Murdock, Wichita, Kansas

15-145-01148-0000

Company- CLARK KNIGHT DRILG.  
Farm- Hutchinson No. 8

SEC. 3 T. 23 R. 17W  
SE NW NW

Total Depth. 4270'  
Comm. 2-7-56 Comp. 2-25-56  
Shot or Treated.  
Contractor.  
Issued. 8-4-56

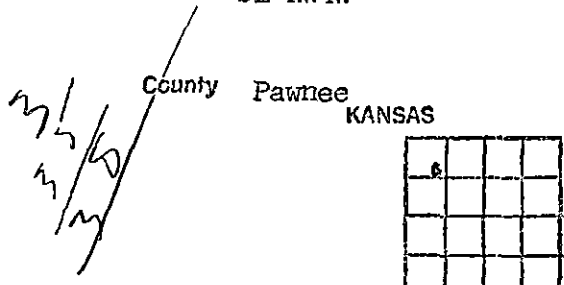

CASING:  
10 3/4" 180' w/150 sx c em.  
5 1/2" 4269'

Elevation. 2067 RB

Production. 807 BOPD

Figures indicate Bottom of Formations.

clay-sand	90
shale shells	180
shale	310
sand	320
shale shells	545
sand	635
shale shells	1090
Anhydrite	1140
shale shells	1755
lime-shale	1770
shale	1900
lime-shale	2025
lime	2190
lime-shale	2650
lime-shells	2740
lime-shale	3460
lime	3540
lime-shale	3630
lime	3681
lime-shale	3720
lime	4100
lime-shale	4170
Conglomerate	4263
lime-chert	4270
Total Depth	

TOPS:

Anhydrite	1090
Heebner	3601
Tcr onto	3620
Douglas	3631
Brwn lime	3709
lime Kansas City	3716
B/Kansas City	3998
Cherokee shale	4126
Cherokee sand	4135
Conglomerate	4152
Mississippi	4216
Viola	4253

Handwritten notes: 2 ~, 10, 12, 17, 47

RECEIVED  
STATE CORPORATION COMMISSION

MAR 1 1963

CONSERVATION DIVISION  
Wichita, Kansas