

STATE OF KANSAS
STATE CORPORATION COMMISSION


WELL PLUGGING RECORD

Give All Information Completely
Make Required Affidavit
Mail or Deliver Report to:
Conservation Division
State Corporation Commission
211 No. Broadway
Wichita, Kansas

Pawnee County, Sec. 3 Twp. 23 Rge. 17 (E) (W)

Location as "NE/CNW/SW" or footage from lines SE SE SW
Lease Owner Clark Knight Drilling Inc.
Lease Name Hutchinson Well No. 6
Office Address 2133 Walnut Drive, Great Bend, Kansas
Character of Well (completed as Oil, Gas or Dry Hole) oil
Date well completed 19
Application for plugging filed 19
Application for plugging approved 19
Plugging commenced August 17 19 62
Plugging completed September 4 19 62
Reason for abandonment of well or producing formation depleted

NORTH

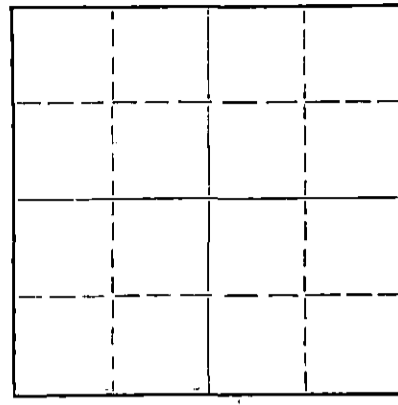

Locate well correctly on above Section Plat

If a producing well is abandoned, date of last production 19
Was permission obtained from the Conservation Division or its agents before plugging was commenced? yes

Name of Conservation Agent who supervised plugging of this well Mr. Lackamp, Stafford
Producing formation Depth to top Bottom Total Depth of Well 4285 Feet
Show depth and thickness of all water, oil and gas formations.

OIL, GAS OR WATER RECORDS

CASING RECORD

FORMATION	CONTENT	FROM	TO	SIZE	PUT IN	PULLED OUT
				8 5/8	185	
				5 1/2	4285	

Describe in detail the manner in which the well was plugged, indicating where the mud fluid was placed and the method or methods used in introducing it into the hole. If cement or other plugs were used, state the character of same and depth placed, from feet to feet for each plug set.

Sanded hole back to 4150', dumped 5 sacks cement
Working pipe 24" tension.
Loaded hole shot and work pipe @ 3628'.
Pumped in hole @ 1100 lbs.
Pumped 45 bbls oil pumped plug 3600'
Shot pipe 3314', 2804', 2628'.
Mixed 75 sacks cement

RECEIVED
STATE CORPORATION COMMISSION

OCT 20 1962

CONSERVATION DIVISION
Wichita, Kansas

10-30-62

(If additional description is necessary, use BACK of this sheet)

Name of Plugging Contractor Pipe Pullers, Inc.
Address Box 486, Ellinwood, Kansas

STATE OF Kansas, COUNTY OF Barton, ss.
Pipe Pullers, Inc. (employee of owner) or (owner or operator) of the above-described well, being first duly sworn on oath, says: That I have knowledge of the facts, statements, and matters herein contained and the log of the above-described well as filed and that the same are true and correct. So help me God.

(Signature) *R. J. Myers*
(Address)

SUBSCRIBED AND SWORN TO before me this 12 day of September, 1962

My commission expires December 18, 1962
Notary Public.

WELL LOG BUREAU—KANSAS GEOLOGICAL SOCIETY
508 East Murdock, Wichita, Kansas


15-145-01146-0000

Company- CLARK KNIGHT DRLG.
Farm- Hutchinson No. 6

SEC. 3 T. 23 R. 17W
CS/2 SE SW

Total Depth. 4285'
Comm. 10-20-55 Comp. 11-3-55
Shot or Treated.
Contractor.
Issued. 8-11-56

County Pawnee
KANSAS

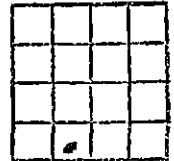

CASING:
8 5/8" 185'
5 1/2" 4285'

Elevation. 2093'

Production. 695 BOPD

Figures indicate Bottom of Formations.

shale, shells	585
sdv shale	670
red rock, shells	790
shale, shells	1070
shale	1130
anhydrite	1170
shale, shells	1845
lime, shale	2100
lime	2305
lime, shale	2370
lime	2450
lime, shale	2500
shale	2510
lime, shale	3650
lime	4180
Conglomerate	4285
Total Depth	

Tops:	
Anhydrite	1130
Base Anhydrite	1170
Heebner	3635
Toronto	3649
Douglas	3664
Brown Lime	3740
Lansing-Kansas City	3748
Base Kansas City	4025
Ft Scott	4148
Cherokee Shale	4155
Conglomerate	4174
Mississippi	4240
Viola	4280

RECEIVED
STATE CORPORATION COMMISSION

OCT 30 1962

CONSERVATION DIVISION
Wichita, Kansas