


Give All Information Completely
Make Required Affidavit
Mail or Deliver Report to:
Conservation Division
State Corporation Commission
211 No. Broadway
Wichita, Kansas

WELL PLUGGING RECORD

15-145-01142-0000

NORTH

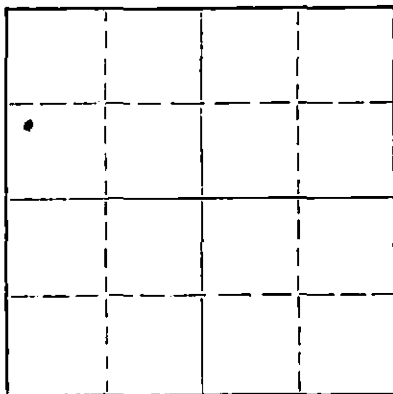

Locate well correctly on above
Section Plat

Pawnee County, Sec. 3 Twp. 23 Rge. (E) 17 (W)
Location as "NE/CNW/SW" or footage from lines NW SW NW
Lease Owner Clark Knight Drilling Company
Lease Name Hutchinson Well No. 2
Office Address 2433 Walnut Drive, Great Bend, Kansas
Character of Well (completed as Oil, Gas or Dry Hole) oil
Date well completed 19.62
Application for plugging filed 10-22 19.62
Application for plugging approved 19.62
Plugging commenced 10-23 19.62
Plugging completed 11-19 19.62
Reason for abandonment of well or producing formation well no longer profitable
If a producing well is abandoned, date of last production 19.62
Was permission obtained from the Conservation Division or its agents before plugging was commenced? YES

Name of Conservation Agent who supervised plugging of this well Bill Lackamp
Producing formation _____ Depth to top _____ Bottom _____ Total Depth of Well 4258 Feet
Show depth and thickness of all water, oil and gas formations.

OIL, GAS OR WATER RECORDS

CASING RECORD

FORMATION	CONTENT	FROM	TO	SIZE	PUT IN	PULLED OUT
				8 5/8"	213	none
				5 1/2"	4257	2857.67

Describe in detail the manner in which the well was plugged, indicating where the mud fluid was placed and the method or methods used in introducing it into the hole. If cement or other plugs were used, state the character of same and depth placed, from _____ feet to _____ feet for each plug set.

Sand hole back to 4100'; dump 5 sacks of cement; fill hole with mud. Pumped 15 sacks of mud and 75 sacks of cement into surface pipe. Top of cement level with floor of cellar.

RECEIVED
STATE CORPORATION COMMISSION

MAR 1 1963

CONSERVATION DIVISION
Wichita, Kansas

3-1-63

(If additional description is necessary, use BACK of this sheet)

Name of Plugging Contractor Pipe Pullers, Inc.
Address Box 486, Ellinwood, Kansas

STATE OF Kansas, COUNTY OF Barton, ss.

_____, (employee of owner) or (owner or operator) of the above-described well, being first duly sworn on oath, says: That I have knowledge of the facts, statements, and matters herein contained and the log of the above-described well as filed and that the same are true and correct. So help me God.

(Signature) Sam Miller

Ellinwood, Kansas

(Address)

SUBSCRIBED AND SWORN TO before me this 3rd day of December 19 62

George A Meyer
Notary Public.

My commission expires February 10, 1963



15-145-01142-0000

Drillers Log.

Company: Clark Knight Drg. Co; Inc.
Farm: Hutchinson #2. Sec.3-T23-R17W, NW SW NW
Bawnee Co; Kans.

Date Comm. 11/16/54 Date Comp. 12/1/54

Casing:

8 5/8" 213' 110sx Cm
5 1/2" 4257' 75 sx Cm.

Bottom Figures.

Surface	213
Shale, shells	420
Sand	455
Shale, shells	505
Sand	630
Shells, shale	1080
Anhydrite	1088
Shale, shells	1440
Shale	1760
Shells, shale	1890
Shale, lime	2390
Lime	2510
Lime, shale	3220
Lime	3280
Lime shale	3365
Lime	3710
Sand, shale	4120
Lime	4200
Lime, chert	4250
T.D.	4258

Form. Tops.

Anhy.	1088
Doug.	3631
Lans-KC	3711
Ch. sand.	4121
Miss.	4202
Viola	4246
T.D.	4258

RECEIVED
STATE CORPORATION COMMISSION

MAR 1 1963

CONSERVATION DIVISION
Wichita, Kansas