


Give All Information Completely
Make Required Affidavit
Mail or Deliver Report to:
Conservation Division
State Corporation Commission
211 No. Broadway
Wichita, Kansas

WELL PLUGGING RECORD

Stafford County, Sec. 12 Twp. 21S Rge. (E) 14(W)
Location as "NE/CNWXSW" or footage from lines C NE SW SW
Lease Owner Rains & Williamson Oil Co.
Lease Name BLAKESLEE Well No. 1
Office Address 1425 Wichita Plaza, Wichita, Kansas
Character of Well (completed as Oil, Gas or Dry Hole) Dry Hole
Date well completed January 2 19 65
Application for plugging filed January 2 19 65
Application for plugging approved January 2 19 65
Plugging commenced January 2 19 65
Plugging completed January 2 19 65
Reason for abandonment of well or producing formation no oil or gas found
in commercial quantities.
If a producing well is abandoned, date of last production - - 19 -
Was permission obtained from the Conservation Division or its agents before plugging was commenced? Yes

NORTH

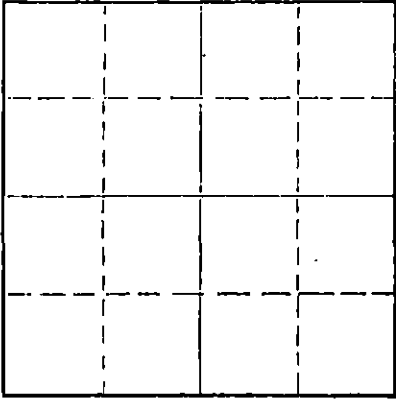

Locate well correctly on above Section Plat

Name of Conservation Agent who supervised plugging of this well Archie Elving, Pratt, Kansas
Producing formation - - Depth to top - - Bottom - - Total Depth of Well 3690 Feet
Show depth and thickness of all water, oil and gas formations.

OIL, GAS OR WATER RECORDS

CASING RECORD

FORMATION	CONTENT	FROM	TO	SIZE	PUR IN	PULLED OUT
				8-5/8"	367'	XXX None

Describe in detail the manner in which the well was plugged, indicating where the mud fluid was placed and the method or methods used in introducing it into the hole. If cement or other plugs were used, state the character of same and depth placed, from _____ feet to _____ feet for each plug set.

Plug and hulls to 300', cemented thru drill pipe with 25 sacks cement, mud back to 40', set solid bridge, plug and hulls, capped with 10 sacks cement, plug down 8:45 p.m. 1-2-65.

RECEIVED
STATE CORPORATION COMMISSION
JAN 8 1965
CONSERVATION DIVISION
Wichita, Kansas
1-8-65

(If additional description is necessary, use BACK of this sheet)
Name of Plugging Contractor Rains & Williamson Oil Co.
Address 1425 Wichita Plaza, Wichita, Kansas

STATE OF KANSAS, COUNTY OF SEDGWICK, ss.
Wilson Rains ~~owner or operator~~ (owner or operator) of the above-described well, being first duly sworn on oath, says: That I have knowledge of the facts, statements, and matters herein contained and the log of the above-described well as filed and that the same are true and correct. So help me God.

(Signature) Wilson Rains
1425 Wichita Plaza, Wichita, Kansas
(Address)

SUBSCRIBED AND SWORN to before me this 7th day of January, 19 65
Shirley Keek
Notary Public.

My commission expires January 8, 1968

ROTARY DRILLING LOG

Operator: Rains & Williamson Oil Co.
 #1 BLAKESLEE
 C NE SW SW Section 12-21S-14W
 Stafford County, Kansas

Contractor: Rains & Williamson
 Oil Co.
 Commenced: 12-26-64
 Completed: 1-2-65
 Remarks: Set 367' 8-5/8" surface
 casing with 225 sacks
 GL3 cement, plus 2% gel.

FORMATIONS:

Sand & Shale	345'
Shale & Red Bed	365'
Red Bed & Shale	817'
Anhydrite	343'
Shale	1275'
Shale & Shells	1630'
Lime & Shale	2200'
Shale & Lime	2530'
Shale & Shells	2870'
Shale & Lime	3040'
Lime & Shale	3116'
Lime	3645'
Simpson Shale	3685'
Lime	3690'

Rotary Total Depth(D&A) 3690'

We certify the above log is true and
 correct to the best of our knowledge and
 belief.

RAINS & WILLIAMSON OIL CO.

Wilson Rains
 Wilson Rains, Partner

Subscribed and sworn to before me, a Notary Public in and for the State of
 Kansas, County of Sedgwick, this 7th day of January, 1965.

My Commission Expires:
 January 8, 1968

Shirley Keck
 Shirley Keck, Notary Public

RECEIVED
 STATE CORPORATION COMMISSION
 JAN 8 1965
 CONSERVATION DIVISION
 Wichita, Kansas