

WELL PLUGGING RECORD

Give All Information Completely
Make Required Affidavit
Mail or Deliver Report to:
Conservation Division
State Corporation Commission
800 Bitting Building
Wichita, Kansas

NORTH

Locate well correctly on above
Section Plat

Finney County, Sec. 13 Twp. 21 Rge. 34 (E) W (W)
Location as "NE/CNW $\frac{1}{4}$ SW $\frac{1}{4}$ " or footage from lines SE SE SE
Lease Owner B & R Drilling, Inc.
Lease Name O'Brien Well No. 1
Office Address Russell, Kansas
Character of Well (completed as Oil, Gas or Dry Hole) Dry Hole
Date well completed 3/15/52 19.
Application for plugging filed 3/14/52 19.
Application for plugging approved 3/14/52 19.
Plugging commenced 3/14/52 19.
Plugging completed 3/14/52 19.
Reason for abandonment of well or producing formation Dry Hole

If a producing well is abandoned, date of last production 19.
Was permission obtained from the Conservation Division or its agents before plugging was commenced? Yes

Name of Conservation Agent who supervised plugging of this well M. A. Rives
Producing formation Depth to top Bottom Total Depth of Well 4945 Feet
Show depth and thickness of all water, oil and gas formations.

OIL, GAS OR WATER RECORDS

CASING RECORD

Formation	Content	From	To	Size	Put In	Pulled Out
				8 5/8"	272	None

Describe in detail the manner in which the well was plugged, indicating where the mud fluid was placed and the method or methods used in introducing it into the hole. If cement or other plugs were used, state the character of same and depth placed, from feet to feet for each plug set.

Plugging Record

Filled hole to 270 ft, set plug and 20 sacks of cement, Filled hole to 35 ft, set plug and 10 sacks of cement.

(If additional description is necessary, use BACK of this sheet)


Name of Plugging Contractor
Address

STATE OF KANSAS, COUNTY OF RUSSELL, ss.
W. A. Michaelis, Jr. (employee of owner) or (owner or operator) of the above-described well, being first duly sworn on oath, says: That I have knowledge of the facts, statements, and matters herein contained and the log of the above-described well as filed and that the same are true and correct. So help me God.

(Signature) W. A. Michaelis, Jr.
Russell, Kansas (Address)

SUBSCRIBED AND SWORN to before me this 28th day of March, 1952

My commission expires 6-17-54. Notary Public.

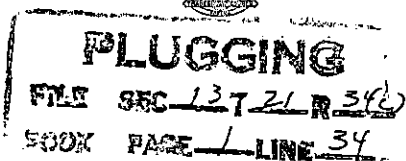

B & R Drilling, Inc.
O'Brien No. 1

SE SE SE of Sec. 13-21-34
Finney County, Kansas

Total Depth: 4945'
Comm. 2/11/52
Comp. 3/15/52

Casing

8 5/8" Set @ 272'

Cement

175 sacks of Atlas

Formation

Depth

Shale-sand	40
Sand	135
Shale-red bed	200
Shale	272
Shale-shells	720
Sand	810
Shale-shells	1044
Red bed-shale	1130
Shale-sand	1220
Shale-red bed	1378
Anhydrite	1405
Shale-red bed-shells	1580
Sand	1780
Shale-red bed-shells	2320
Lime-shale-red bed	2525
Lime-shale	2650
Lime	2660
Lime-shale	2820
Lime	4674
Shale-sand	4681
Coring	4731
Lime-shale	4847
Lime	4945'

STATE OF KANSAS)
) ss
RUSSELL COUNTY)

I hereby certify that the above information is true and
correct to the best of my knowledge.

-----*Lora Bety*-----

Subscribed and sworn to before me this 28th day of March, 1952.

-----*Clara L. Linn*-----
Notary Public

My commission expires: 6-17-54.

PLUGGING
BOOK PAGE 1 LINE 34