

9

STATE OF KANSAS
STATE CORPORATION COMMISSION


Form CP-4

WELL PLUGGING RECORD

Give All Information Completely
Make Required Affidavit
Mail or Deliver Report to:
Conservation Division
State Corporation Commission
211 No. Broadway
Wichita, Kansas

Finney County, Sec. 13 Twp. 21 Rge. 34 (E) W (W)
C SE

Location as "NE/CNW/SW" or footage from lines _____
Lease Owner Reserve Pipe Line
Lease Name Christ Well No. 1
Office Address Box 1274, Liberal, Kansas 67901
Character of Well (completed as Oil, Gas or Dry Hole) _____
Date well completed _____ 19____
Application for plugging filed _____ 19____
Application for plugging approved _____ 19____
Plugging commenced _____ 5/10/ 19 71
Plugging completed _____ 5/11/ 19 71
Reason for abandonment of well or producing formation _____

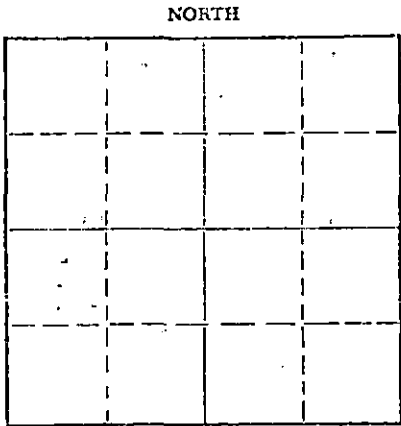

Locate well correctly on above Section Plat

If a producing well is abandoned, date of last production _____ 19____
Was permission obtained from the Conservation Division or its agents before plugging was commenced? _____

Name of Conservation Agent who supervised plugging of this well _____
Producing formation _____ Depth to top _____ Bottom _____ Total Depth of Well 2605' Feet
Show depth and thickness of all water, oil and gas formations.

OIL, GAS OR WATER RECORDS

CASING RECORD

FORMATION	CONTENT	FROM	TO	SIZE	PUT IN	PULLED OUT

RECEIVED
STATE CORPORATION COMMISSION
JUN 7 1971
CONSERVATION DIVISION
Wichita, Kansas
6-7-71

Describe in detail the manner in which the well was plugged, indicating where the mud fluid was placed and the method or methods used in introducing it into the hole. If cement or other plugs were used, state the character of same and depth placed, from _____ feet to _____ feet for each plug set.

Hole filled with sand to 1,910'.
Put 5 sks. cement at 1,910' to 1,850'.
Pump 35 sks. cement at 370' to 270'.
Put 15 sks. cement at 45' to 0'.

(If additional description is necessary, use BACK of this sheet)

Name of Plugging Contractor _____
Address _____

STATE OF KANSAS COUNTY OF SEWARD / _____, ss.
CHESTER A. NORDLING

(Notary Public) or (owner or operator) of the above-described well, being first duly sworn on oath, says: That I have knowledge of the facts, statements, and matters herein contained and the log of the above-described well as filed and that the same are true and correct. So help me God. SARGENT'S CASING PULLING SERVICE

(Signature) Chester A. Nordling Partner
Box 506, Liberal, Kansas 67901
(Address)



Subscribed and Sworn to before me this 26th day of May, 19 71
My Commission Expires Jan. 22, 1973
Mary Ann Stoddard
Notary Public.
Mary Ann Stoddard

CERTIFIED DRILLER'S LOG

COMPANY: RESERVE PIPELINE, INC.

CONTRACTOR: LONITA OIL CORPORATION, INC.

COMMENCED: DECEMBER 1, 1962

COMPLETED: DECEMBER 6, 1962

ELEVATION: 2922' R. B.

LEASE: CRIST #1

LOCATION: C SE/4 SECTION 13-21S-34W
FINNEY COUNTY, KANSASCASING RECORD: 371' 8 3/8", cem. with 285 sacks
2605' 4 1/2", cem. with 300 sacksRECEIVED
STATE CORPORATION COMMISSION
APR 12 1971
CONSERVATION DIVISION
Wichita, Kansas


<u>FORMATION:</u>	<u>DEPTH:</u>
Clay, Sand & Shale	0-971
Shale & Shells	971-1380
Shale, Sand & Lime	1380-1820
Shale & Anhydrite	1820-2100
Shale & Shells	2100-2236
Shale & Lime	2236-2334
Lime	2334-2605
RTD	2605

I hereby certify that this is a true and correct copy of the above log to the best of my knowledge.


R. E. Hartman

STATE OF KANSAS)
COUNTY OF SEDGWICK }

Subscribed and sworn to before me this 25th day of January, 1963.


Notary Public

My Commission Expires: November 28, 1964