


STATE OF KANSAS  
STATE CORPORATION COMMISSION

WELL PLUGGING RECORD

Give All Information Completely  
Make Required Affidavit  
Mail or Deliver Report to:  
Conservation Division  
State Corporation Commission  
800 Bitting Building  
Wichita, Kansas

NORTH

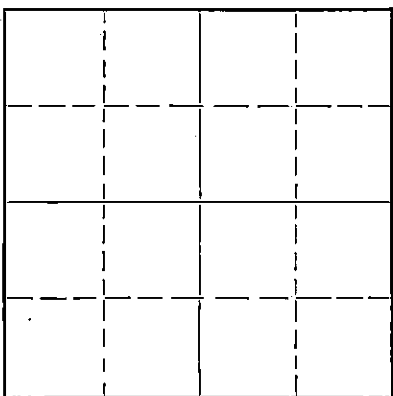

Locate well correctly on above  
Section Plat

Rice County, Sec. 15 Twp. 21 Rge. 8 (E) W (W)  
Location as "NE/CNW $\frac{1}{4}$ /SW $\frac{1}{4}$ " or footage from lines C SE SE NW  
Lease Owner Pickrell Drilling Company  
Lease Name BELL Well No. 1  
Office Address 705 4th National Bank Building, Wichita 2, Kansas  
Character of Well (completed as Oil, Gas or Dry Hole) Dry Hole  
Date well completed 6/25/1952  
Application for plugging filed 6/25/1952  
Application for plugging approved 6/25/1952  
Plugging commenced 6/25/1952  
Plugging completed 6/25/1952  
Reason for abandonment of well or producing formation D & A

If a producing well is abandoned, date of last production 19  
Was permission obtained from the Conservation Division or its agents before plugging was commenced? Yes

Name of Conservation Agent who supervised plugging of this well Mr. Ruel Durkee  
Producing formation Depth to top Bottom Total Depth of Well 3733 Feet  
Show depth and thickness of all water, oil and gas formations.

OIL, GAS OR WATER RECORDS

CASING RECORD

Formation	Content	From	To	Size	Put In	Pulled Out
				8 5/8"	215'	None
No oil string was run.						

Describe in detail the manner in which the well was plugged, indicating where the mud fluid was placed and the method or methods used in introducing it into the hole. If cement or other plugs were used, state the character of same and depth placed, from feet to feet for each plug set.

Filled hole with heavy mud from 3733' to 213'. Set bridge at 213' and filled with 20 sacks of cement. Filled with heavy mud to 30' and cemented with 10 sacks to bottom of cellar.

(If additional description is necessary, use BACK of this sheet)

Name of Plugging Contractor Pickrell Drilling Company  
Address 705 Fourth National Bank Building  
Wichita 2, Kansas

STATE OF Kansas, COUNTY OF Sedgwick, ss.  
C. W. Sebitts (owner or operator) of the above-described well,

being first duly sworn on oath, says: That I have knowledge of the facts, statements, and matters herein contained and the log of the above-described well as filed and that the same are true and correct. So help me God.

(Signature) [Signature]  
705 4th National Bank Bldg., Wichita 2, Kansas  
(Address)

SUBSCRIBED AND SWORN to before me this 1st day of July, 1952.

My commission expires January 28, 1953

[Signature] Notary Public.

PLUGGING  
FILE SEC-15T-2(R)2  
BOOK PAGE 27 LINE 30

STATE CORPORATION COMMISSION  
JUL - 2 1952 7-2-52  
CONSERVATION DIVISION  
Wichita, Kansas

COMPANY: PICKRELL DRILLING COMPANY, ETAL. Rotary Drilling Commenced: 6/13/52  
 Wichita, Kansas Rotary Drilling Completed: 6/25/52

LOCATION: BELL #1, SE SE NW 15-21S-8W  
 Rice County, Kansas

CONTRACTOR: PICKRELL DRILLING COMPANY  
 Wichita 2, Kansas

CASING RECORD: 215' of 8 5/8" 21# J-55 Smls. Casing set at 213' in a 12 1/4" hole,  
 cemented with 150 sacks cement.  
 Drilled 7 7/8" hole from 213' to 3733' T.D. No oil string run.

L O G

(Figures indicate bottom formation - measurements from top rotary bushing.)

Sand & Red Bed	213	Circulate for samples at 3096'
Shale	1070	3164'
Anhydrite	1110	3241'
Shale & Shells	1500	3263'
Lime	1555	3304'
Lime & Shale Breaks	1770	3309'
Lime & Shale	1975	3322'
Shale & Shells	2170	3335'
Lime	2785	3348'
Shale & Lime	2930	3508'
Lime	3298	3560'
Conglomerate	3309	3566'
Chert & Lime	3345	3582'
Chert	3348	3649'
Shale	3469	3655'
Lime	3733 Rotary T.D.	3685'
		3702'
		3730'

Slope Test @ 2500' - 0° off.  
 3000' - 0° off.  
 S. L. M. @ 2500' - OK.  
 Lost circulation @ 3198'

The undersigned, C. W. Sebitts, Attorney-in-fact of Pickrell Drilling Company, hereby certifies in behalf of said company, that the above log is a true and correct log of the formation encountered in drilling the above well as reflected by the Daily Drilling Reports.

PICKRELL DRILLING COMPANY

By *C. W. Sebitts*  
 Attorney-in-fact

STATE OF KANSAS )  
 COUNTY OF SEDGWICK ) SS

On this 1st day of July, 1952, before me the undersigned, a Notary Public in and for the County and State aforesaid personally appeared C. W. Sebitts, to me known to be the identical person who subscribed the name of Pickrell Drilling Company to the foregoing instrument as its Attorney-in-fact and acknowledged to me that he executed the same as his free and voluntary act and deed, and as the free and voluntary act and deed of such company, for the uses and purposes therein set forth.

Given under my hand and seal of office the day and year last above written.

*Ethel Zimmerman*  
 Notary Public

My commission expires January 28, 1953.

**PLUGGING**  
 FILE SEC 15 T 21 R 10  
 PAGE 27 LINE 50

RECEIVED  
 STATE CORPORATION  
 CONSERVATION DIVISION  
 WICHITA, KANSAS