

DISTRICT CONSERVATION AGENT'S REPORT

TO:

State Corporation Commission
Conservation Division
800 Bitting Building
Wichita, Kansas

FILE NO. _____

LOCATION SE-SE-SESEC. 13 TWP. 21 RGE. 34WDry Hole X Abandoned Oil Well _____ Abandoned Gas Well _____

I have today completed supervision of plugging of:


Well No. 1 Lease O'BrienOperator B. R. Dill Co Address Russell KansasField _____ County FurnessTotal Depth 4945' Feet.

(Describe briefly the manner in which the well was plugged)

8 1/2" 272' circulated with cement
filled with rotary mud to 270' set
plug run 20 sk cement through drill
pipe. Mud to 35' set plug run 10 sk
cement cap.

Mr Jack Sullivan
Drilling Supt

3-17-52

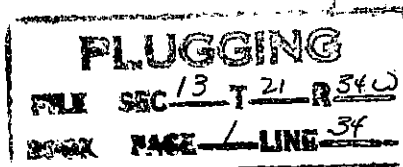

W. E. Rivers
District Conservation Agent

Date 3-14-52