


STATE OF KANSAS
STATE CORPORATION COMMISSION

WELL PLUGGING RECORD

Give All Information Completely
Make Required Affidavit
Mail or Deliver Report to:
Conservation Division
State Corporation Commission
800 Bitting Building
Wichita, Kansas

NORTH

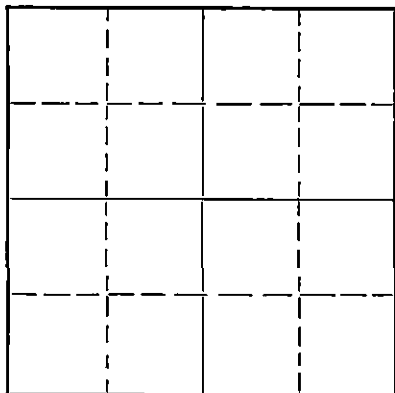

Locate well correctly on above
Section Plat

Stafford County. Sec. 32 Twp. 21 Rge. 14 (E) (W)
Location as "NE/CNW $\frac{1}{4}$ SW $\frac{1}{4}$ " or footage from lines SW NE NE
Lease Owner Petroleum, Inc.
Lease Name Cox 'A' #3 Well No. 3
Office Address 100 Derby Bldg., Wichita, Kansas
Character of Well (completed as Oil, Gas or Dry Hole) Dry Hole
Date well completed January 12, 19 52
Application for plugging filed January 12, 19 52
Application for plugging approved January 12, 19 52
Plugging commenced January 12, 19 52
Plugging completed January 12, 19 52
Reason for abandonment of well or producing formation Dry Hole

If a producing well is abandoned, date of last production 19
Was permission obtained from the Conservation Division or its agents before plugging was commenced? Yes

Name of Conservation Agent who supervised plugging of this well Mr. C. D. Stough
Producing formation Depth to top Bottom Total Depth of Well 3810 Feet
Show depth and thickness of all water, oil and gas formations.

OIL, GAS OR WATER RECORDS

CASING RECORD

Formation	Content	From	To	Size	Put In	Pulled Out
				8 5/8"	251'	None

Describe in detail the manner in which the well was plugged, indicating where the mud fluid was placed and the method or methods used in introducing it into the hole. If cement or other plugs were used, state the character of same and depth placed, from feet to feet for each plug set.

Placed wooden plug at 251'. Cemented and displaced 15 sack cement through drill pipe on to plug. Mudded up to 35' and placed second wooden plug at 35'. Placed 10 sacks cement on top of plug filling hole to bottom of cellar.

IAN 22 1952 -
CONSERVATION DIVISION
WICHITA, KANSAS

1-22-52

(If additional description is necessary, use BACK of this sheet)
Correspondence regarding this well should be addressed to Petroleum, Inc.
Address 100 Derby Bldg., Wichita, Kansas

STATE OF KANSAS, COUNTY OF SEDGWICK, ss.
Eric H. Jager (employee of owner) of the above-described well, being first duly sworn on oath, says: That I have knowledge of the facts, statements, and matters herein contained and the log of the above-described well as filed and that the same are true and correct. So help me God.

(Signature) Eric H. Jager
100 Derby Bldg., Wichita, Kansas (Address)

SUBSCRIBED AND SWORN TO before me this 21st day of January, 19 52
Charlotte Weisman
Notary Public.

My commission expires October 13, 1954
23-3273-s 4-50-10M

PLUGGING
FILE SEC 32 T 21 R 14
BOOK PAGE 137 LINE 23

WELL LOG COX 'A' NO. 3

Petroleum, Inc., Lease Owner

Section 32, Twp. 21S, Rge. 14W

Garvey Drilling Company, Contractor

Location: SW NE NE

Drilling Commenced: December 30, 1951

County: Stafford

Drilling Completed: January 12, 1952

Elevation: 1948 R.B.

Casing: 8 5/8" @ 251' w/175 sax

R. T. D.: 3810'

Figures below indicate bottom of formation:

20 Clay
 225 Sand
 330 Shale & Shells
 425 Sand
 872 Shale & Red Bed
 896 Anhydrite
 1570 Shale & Shells
 3170 Lime & Shale
 3305 Lime
 3385 Lime & Shale
 3423 Shale
 3705 Lime
 3710 Conglomerate
 3753 Viola
 3792 Shale & Lime
 3806 Shale
 3810 Lime
 3810' R.T.D.

Tops:

Heebner: 3297 (-1349)
 Brown Lime: 3413 (-1465)
 Lansing: 3422 (-1474)
 Conglomerate: 3701 (-1753)
 Simpson: 3748 (-1800)
 Arbuckle: 3806 (-1858)

I hereby certify that this is a true and correct log of the above mentioned well.

PETROLEUM, INC.

By Eric H. Jager
Eric H. Jager

STATE OF KANSAS)
) SS:
COUNTY OF SEDGWICK)

Subscribed to and sworn to before me, a Notary Public, in said County and State, this 21st day of January, 1952.

PLUGGING
 FILE SEC 32T 21 R (4W)
 BOOK PAGE 137 line 23

Charlotte Weidman
Notary Public

JAN 22 1952
My commission expires: October 13, 1954