


STATE OF KANSAS  
STATE CORPORATION COMMISSION  
CONSERVATION DIVISION  
P. O. BOX 17027  
WICHITA, KANSAS 67217

FORM CP-4

WELL PLUGGING RECORD

Stafford County, Sec. 32 Twp. 21S Rgd. (E) 14 (W)

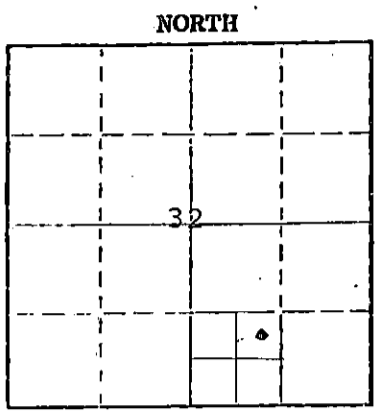

Locate well correctly on above Section Plot

Location as "NE/CNW4SW4" or footage from lines NE SW SE  
Lease Owner CHAPMAN EXPLORATION, INC.  
Lease Name BAUER Well No. 3  
Office Address 404 Cities Service Bldg., Tulsa, Okla. 74119  
Character of Well (completed as Oil, Gas or Dry Hole) Oil, converted to WIW  
Date well completed November 5 19 56  
Application for plugging filed December 27 19 79  
Application for plugging approved January 16 19 80  
Plugging commenced March 20 19 80  
Plugging completed March 21 19 80  
Reason for abandonment of well or producing formation Bad casing

If a producing well is abandoned, date of last production 19  
Was permission obtained from the Conservation Division or its agents before plugging was commenced? Yes

Name of Conservation Agent who supervised plugging of this well William T. Owen, Pratt, Kansas  
Producing formation Injection - LKC Depth to top 3569' Bottom 3576' Total Depth of Well 3860 Feet  
Show depth and thickness of all water, oil and gas formations.

OIL, GAS OR WATER RECORDS

CASING RECORD

FORMATION	CONTENT	FROM	TO	SIZE	PUT IN	PULLED OUT
LKC	Water	3569'	3576'	8-5/8"	283'	None
Arbuckle	Water	3848'	3860'	5-1/2"	3853'	None

Describe in detail the manner in which the well was plugged, indicating where the mud fluid was placed and the method or methods used in introducing it into the hole. If cement or other plugs were used, state the character of same and depth placed, from feet to feet for each plug set.

Ran tubing to 3560'. Mix 100 sks 50/50 poz, 2% gel, and displace to bottom. Pick up tubing and fill hole with mud. Mix 50 sks and displace at 700'. Pull tubing out. Push rubber plug to 200' and mix 60 sks and displace on top of plug, went down hole. Shut in overnight. Mix 40 sks and fill hole to the surface. Attempted to pump cement in annulus, pressured up. Had previously pumped 75 sks poz in annulus on 11-9-79. Job complete.

(If additional description is necessary, use BACK of this sheet)

Name of Plugging Contractor Bill's Well Service AND Sun Cementing Company  
Address Codell, Kansas Great Bend, Kansas

STATE OF OKLAHOMA COUNTY OF TULSA  
I, Virgil L. Johnson (employee of owner) of the above-described

well, being first duly sworn on oath, says: That I have knowledge of the facts, statements, and matters herein contained and the log of the above-described well as filed and that the same are true and correct. So help me God.

(Signature) *Virgil L. Johnson*

404 Cities Service Bldg., Tulsa, Okla. 74119  
(Address)

SUBSCRIBED AND SWORN TO before me this 26th day of March 19 80

*Marjorie J. Kriger*  
Notary Public.

My commission expires JUNE 7, 1980

RECEIVED  
CORPORATION COMMISSION  
MAR 31 1980  
CONSERVATION DIVISION  
Wichita, Kansas