


WELL PLUGGING RECORD

Give All Information Completely
Make Required Affidavit
Mail or Deliver Report to:
Conservation Division
State Corporation Commission
800 Bittig Building
Wichita, Kansas

NORTH

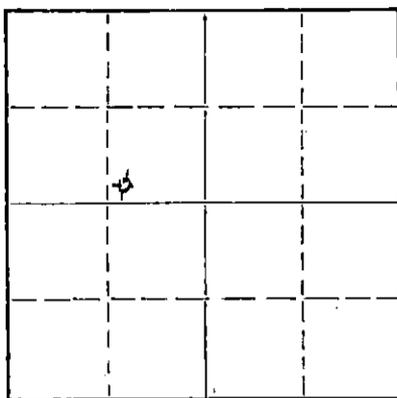

Locate well correctly on above
Section Plat

Barton County. Sec. 27 Twp. 16 Rge. 12 (E) (W)
Location as "NE/CNW%SW%" or footage from lines SW SE NW
Lease Owner Jay Bergman Oil Company - Duke Drilling Company
Lease Name Rieman Well No. 1
Office Address Union Center Building, Wichita, Kansas
Character of Well (completed as Oil, Gas or Dry Hole) Dry Hole
Date well completed 8-19 19 56
Application for plugging filed 8-19 19 56
Application for plugging approved 8-19 19 56
Plugging commenced 8-19 19 56
Plugging completed 8-19 19 56
Reason for abandonment of well or producing formation Dry Hole

If a producing well is abandoned, date of last production _____ 19 ____
Was permission obtained from the Conservation Division or its agents before plugging was commenced? Yes

Name of Conservation Agent who supervised plugging of this well Russell Brundage
Producing formation _____ Depth to top _____ Bottom _____ Total Depth of Well 3383' Feet
Show depth and thickness of all water, oil and gas formations.

OIL, GAS OR WATER RECORDS

CASING RECORD

FORMATION	CONTENT	FROM	TO	SIZE	PUT IN	PULLED OUT
				8 5/8"	314'	None

Describe in detail the manner in which the well was plugged, indicating where the mud fluid was placed and the method or methods used in introducing it into the hole. If cement or other plugs were used, state the character of same and depth placed, from _____ feet to _____ feet for each plug set.

Filled hole with heavy mud to 300'. Set bottom plug at 300' with 1/3 sk Hulls and 20 sacks cement. Heavy mud to 35'. Set plug with 1/3 sk Hulls and 10 sks cement.

(If additional description is necessary, use BACK of this sheet)

Name of Plugging Contractor Duke Drilling Company
Address Box 123, Great Bend, Kansas

STATE OF _____, COUNTY OF _____, ss.

_____, (employee of owner) or (owner or operator) of the above-described well, being first duly sworn on oath, says: That I have knowledge of the facts, statements, and matters herein contained and the log of the above-described well as filed and that the same are true and correct. So help me God.

(Signature) Olson

(Address)

SUBSCRIBED AND SWORN TO before me this 24 day of September, 1956

Chas E. Stinson
Notary Public.

My commission expires June 24, 1959

PLUGGING
FILE SEC. 27 T. 16 R. 12W
BOOK PAGE 92 LINE 1

COMMISSION
DIVISION
Wichita, Kansas

9-25-56

WELL LOG

Date Started: 8-9-56
Date Completed: 8-19-56

Rieman No. 1
SW SE NW
27-16S-12W
Barton County, Kansas

Elevation	1907'	K.B.
Anhydrite	789'	(-1118)
Base Anhydrite	814'	(-1093)
Heebner	2982'	(-1075)
Toronto	2998'	(-1091)
Douglas	3010'	(-1108)
Brown Lime	3072'	(-1165)
Lansing K.C.	3089'	(-1182)
Base K.C.	3320'	(-1417)
Conglomerate	3302'	(-1445)
Arbuckle	None	
R.T.D.	3383'	(-1476)

0'	-	20'	Surface Clay
20'	-	30'	Clay and Rock
30'	-	40'	Sand
40'	-	90'	Shale and Rock
90'	-	100'	Sand
100'	-	140'	Shale
140'	-	150'	Sand
150'	-	205'	Shale
205'	-	225'	Sand
225'	-	300'	Broken Shale
300'	-	314'	Shale
314'	-	390'	Shale
390'	-	415'	Sand and Shale
415'	-	500'	Shale
500'	-	789'	Red Bed
789'	-	814'	Anhydrite
814'	-	1200'	Shale and Shells
1200'	-	1375'	Salt and Shale
1375'	-	1550'	Shale and Shells
1550'	-	1705'	Shale, Shells and Lime
1705'	-	1982'	Lime and Shale
1982'	-	2400'	Lime and Shale
2400'	-	2690'	Lime and Shale
2690'	-	2900'	Lime
2900'	-	2982'	Lime
2982'	-	3089'	Heebner
3089'	-	3115'	Lansing
3115'	-	3268'	Lime
3268'	-	3302'	Lime
3302'	-	3383'	Conglomerate
3383'			R.T.D.

AFFIDAVIT

State of Kansas County of Barton

I, Cecil M. Olson, employee of the owner, do swear that the statements and matter herein contained are true to the best of my knowledge.

THE DUKE DRILLING COMPANY

BY: Cecil M. Olson

Subscribed and sworn before me this 26 day of September, 1956.

Chas. E. Johnson
NOTARY PUBLIC

My commission expires: June 24, 1959.

PLUGGING	
FILE	SEC 27 T 16 R 12W
BOOK	PAGE 92 LINE 1