


WELL PLUGGING RECORD

Give All Information Completely  
Make Required Affidavit  
Mail or Deliver Report to:  
Conservation Division  
State Corporation Commission  
800 Bittling Building  
Wichita, Kansas

NORTH

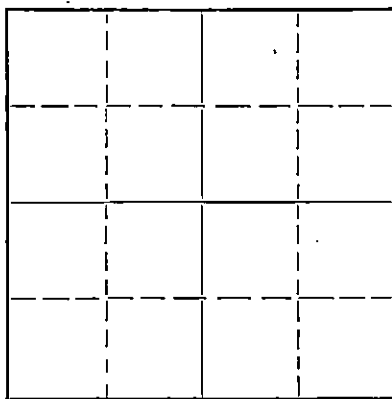

Locate well correctly on above  
Section Plat

Barton County, Sec. 27 Twp. 16S Rge. 12 (E) W (W)  
Location as "NE/CNW $\frac{1}{4}$ /SW $\frac{1}{4}$ " or footage from lines NE NE NE  
Lease Owner The Vickers Petroleum Co., Inc.  
Lease Name Penka "B" Well No. 1  
Office Address Box 2240 Wichita, Kansas  
Character of Well (completed as Oil, Gas or Dry Hole) Oil  
Date well completed January 30 19.50  
Application for plugging filed July 17 19.53  
Application for plugging approved July 17 19.53  
Plugging commenced July 18 19.53  
Plugging completed July 22 19.53  
Reason for abandonment of well or producing formation Depleted.

If a producing well is abandoned, date of last production June 28 19.53  
Was permission obtained from the Conservation Division or its agents before plugging was commenced? Yes

Name of Conservation Agent who supervised plugging of this well Mr. M. A. Rives Pratt, Kansas  
Producing formation Depth to top Bottom Total Depth of Well 3384 Feet  
Show depth and thickness of all water, oil and gas formations.

OIL, GAS OR WATER RECORDS

CASING RECORD

Formation	Content	From	To	Size	Put In	Pulled Out
				8 5/8	316	none
				5 1/2	3369 1/2	2812

Describe in detail the manner in which the well was plugged, indicating where the mud fluid was placed and the method or methods used in introducing it into the hole. If cement or other plugs were used, state the character of same and depth placed, from feet to feet for each plug set.

Plugged back w/ rock to 3300'. Dumped 5 sx cement.  
Top of cement 3265'. Filled hole w/ mud to 300', set rock bridge.  
Dump 20 sx cement, Top of cement 230'. Filled w/ mud to 35'.  
Dump 10 sx cement for cap.

REC-100  
8-8-53

(If additional description is necessary, use BACK of this sheet)

Name of Plugging Contractor Miller Casing Pulling Company  
Address Great Bend, Kansas


STATE OF Kansas COUNTY OF Sedgwick, ss.  
John M. Little (employee of owner) or (owner or operator) of the above-described well,  
being first duly sworn on oath, says: That I have knowledge of the facts, statements, and matters herein contained and the log of the above-described well as filed and that the same are true and correct. So help me God.

(Signature) *John M. Little*  
Box 2240 Wichita, Kansas  
(Address)

SUBSCRIBED AND SWORN to before me this 6 day of August, 1953.

*Allen J. Denton*  
Notary Public.

My commission expires August 13, 1953.

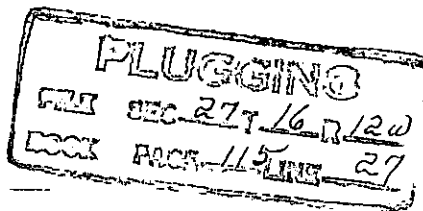

THE VICKERS PETROLEUM CO., INC.

Penka "B" Well #1  
NE NE NE Sec. 27-16S-12W  
Barton County, Kansas

Casing Record:  
8-5/8" @ 316' w/145 sx  
5-1/2" @ 3369 1/2' w/75 sx

Commenced: January 5, 1950  
Completed: January 30, 1950

Elevation: 1922 R.B.  
Potential: 47 BO / 8% water

L O G

Shale & Shells	0-180
Sand, Shale & Shells	180-317
Shale, Shells & Sand	317-560
Red Bed & Shale	560-805
Anhydrite	805-832
Shale & Shells	832-1290
Shale & Salt	1290-1480
Shale & Lime	1480-1540
Lime Broken	1540-1675
Lime Broken & Sand	1675-1905
Lime	1905-1970
Lime Broken	1970-2170
Lime & Shale	2170-2615
Lime	2615-3021
Shale & Sand	3021-3082
Lime & Shale	3082-3342
Shale & Lime	3342-3369
Dolomite	3369-3372 RTD
Cable Tools	3372-3384 T.D.

E. D. 3372-3375  
Fill up 400' w/oil no water in 14 hrs.  
Acidize w/1000 gal. No increase.  
Fill up 250' oil in 14 hrs.  
Swab 1/4 BOPH 8 hrs. No water.  
Fill up 100' oil in 14 hrs.  
D. D. 3375-3381 No increase  
Oil 3381-3383, Swab 3/4 BOPH 4 hrs.  
D. D. 3383-3384 T.D. No increase  
Acidize w/500 gal. Swab down and  
swab avg. 2 1/2 BOPH 8 hrs. Fill up  
1100' oil plus 3 bailers water.  
Acidize w/1000 gal. No increase.

November 7, 1951  
Plugged back to 3245.  
Perforated 3181 to 3193.  
No oil, cemented off and  
drilled back to 3384 T.D.

Tops:  
Heebner  
Brown Lansing  
White Lansing  
Arbuckle  
Soft Zone

2994  
3082  
3100  
3369  
3182-3315

RECEIVED  
FEB 19 1950  
CONSERVATION DEPARTMENT  
Wichita, Kansas

I hereby certify that this log is true and correct to the best of my knowledge and belief.

THE VICKERS PETROLEUM CO., INC.

By

*H. C. Davis*

Sworn and subscribed to before me  
this 22nd day of February, 1950.

*Allen P. Denton*  
Notary Public

My commission expires Aug. 13, 1953.

**PLUGGING**  
FILE SEC 27 T 16 R 12 W  
BOOK PAGE 115 LINE 27