


Give All Information Completely
Make Required Affidavit
Mail or Deliver Report to:
Conservation Division
State Corporation Commission
800 Biting Building
Wichita, Kansas

15-009-15811-00-00

WELL PLUGGING RECORD

NORTH

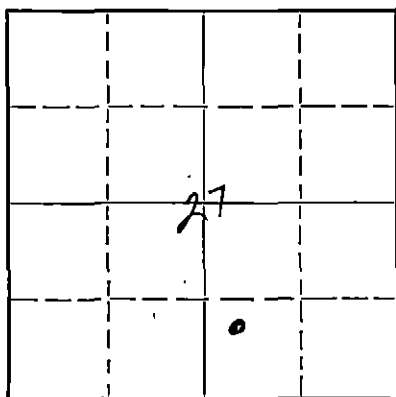

Locate well correctly on above
Section Plat

Barton County. Sec. 27 Twp 16 Rge. 12 (E) W (W)
Location as "NE/CNW $\frac{1}{4}$ SW $\frac{1}{4}$ " or footage from lines NW SW SE
Lease Owner Honaker Drilling Co., Inc., et al
Lease Name McLaughlin Well No. 1
Office Address Great Bend, Kansas
Character of Well (completed as Oil, Gas or Dry Hole) Oil
Date well completed 7-12 1950
Application for plugging filed 12-11 1950
Application for plugging approved 12-12 1950
Plugging commenced 1-7- 1951
Plugging completed 1-9 1951
Reason for abandonment of well or producing formation Well making 1-1/4
bbls oil and 23 bbls water
If a producing well is abandoned, date of last production 11-9 1950
Was permission obtained from the Conservation Division or its agents before plugging was com-
menced? Yes

Name of Conservation Agent who supervised plugging of this well C. D. Stough
Producing formation Arbuckle Depth to top 3365' Bottom 3382' Total Depth of Well 3382' Feet
Show depth and thickness of all water, oil and gas formations.

OIL, GAS OR WATER RECORDS

CASING RECORD

Formation	Content	From	To	Size	Put In	Pulled Out
Arbuckle	Oil & Water	3365	3382	5 1/2"	3365	2513

Describe in detail the manner in which the well was plugged, indicating where the mud fluid was placed and the method or methods used in introducing it into the hole. If cement or other plugs were used, state the character of same and depth placed, from feet to feet for each plug set.

Lane-Wells bridging plug set at 3103', dumped 5 sacks cement at 3080' with dump bailer. Top cement at 3045', filled with heavy mud to 260' of top. Set rock bridge, dumped 15 sacks cement. Top cement 220'. Filled with Mud to 30' of top, dumped 10 sacks cement for cap.

(If additional description is necessary, use BACK of this sheet)

Correspondence regarding this well should be addressed to Honaker Drilling Co., Inc.
Address Great Bend, Kansas

STATE OF Kansas, COUNTY OF Barton, ss.
E. O. Squires (employee of owner) or (owner or operator) of the above-described well,
being first duly sworn on oath, says: That I have knowledge of the facts, statements, and matters herein contained and the log of the above-described well as filed and that the same are true and correct. So help me God.

(Signature) E. O. Squires

Great Bend, Kansas
(Address)

SUBSCRIBED AND SWORN to before me this 15th day of January, 1951

My commission expires 9-1-54

28-5091-S 8-50-10M

PLUGGING
FILE SEC 27 T 16 R 12
BOOK PAGE 48 LINE 12

STATE CORPORATION COMMISSION Notary Public.

JAN 16 1951

CONSERVATION DIVISION
Wichita, Kansas

DRILLER'S LOG

15-009-15811-00-00

Operator Honaker Drilling Co., Inc.

Contractor Honaker Drilling Co., Inc.

Lease McLaughlin #1

C Run 261' surface casing, cemented with 150 sacks cement, 200# CaCl.

	<u>From</u>	<u>To</u>
Top Soil & Rock	0	40
Shale & Iron	40	260
Shells	260	315
Red Bed	315	335
Clay shells	335	430
Shale	430	438
Anhydrite	438	457
Shale, Sand & Shells	457	745
Lime	745	776
Shale & Shells	776	1050
Shale	1050	1430
Lime	1430	1685
Lime & Shale	1685	1810
Broken Lime	1810	1890

	<u>From</u>	<u>To</u>
Lime & Shale	1890	2075
Lime	2075	2150
Lime & Shale	2150	2350
Shale & Shells	2350	2470
Lime & Shale	2470	2860
Broken Lime	2860	2915
Lime	2915	3007
Shale	3007	3070
Lime	3070	3320
Lime & Conglomerate	3320	3360
Lime	3360	3365

T. D. 3365'

(Above depths are Rotary Bushing Measurements, less 4' to ground level)

Run 3372'-45'' casing, cemented with 100 sacks cement.

The foregoing is correct to the best of my knowledge.

HONAKER DRILLING CO., INC.

By

W. J. Honaker
President

RECEIVED
STATE CORPORATION COMMISSION

DEC 12 1950

CONSERVATION DIVISION
Wichita, Kansas

27-66-12W
EP-12