


STATE OF KANSAS
STATE CORPORATION COMMISSION

Form CP-4

WELL PLUGGING RECORD

Give All Information Completely
Make Required Affidavit
Mail or Deliver Report to:
Conservation Division
State Corporation Commission
212 No. Market
Wichita, Kansas

NORTH

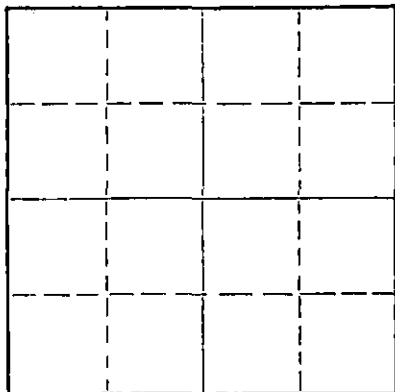

Locate well correctly on above
Section Plat

STAFFORD County, Sec. 7 Twp. 21 Rge. (E) 14 (W)
Location as "NE/CNW/SW" or footage from lines CNE NW SW
Lease Owner SANTA-FE PIPE & SUPPLY, INC.
Lease Name HULLMAN Well No. 2
Office Address P. O. BOX 562, GREAT BEND, KANSAS
Character of Well (completed as Oil, Gas or Dry Hole) OIL
Date well completed MARCH 21 19 51
Application for plugging filed JANUARY 11 19 66
Application for plugging approved JANUARY 12 19 66
Plugging commenced JANUARY 11 19 66
Plugging completed FEBRUARY 2 19 66
Reason for abandonment of well or producing formation DEPLETED

If a producing well is abandoned, date of last production 19
Was permission obtained from the Conservation Division or its agents before plugging was commenced? YES

Name of Conservation Agent who supervised plugging of this well ARCHIE ELVING
Producing formation _____ Depth to top _____ Bottom _____ Total Depth of Well 3737 Feet
Show depth and thickness of all water, oil and gas formations.

OIL, GAS OR WATER RECORDS

CASING RECORD

FORMATION	CONTENT	FROM	TO	SIZE	PUT IN	PULLED OUT
				8 5/8"	906'	NONE
				5 1/2"	3734'	2214.91'

Describe in detail the manner in which the well was plugged, indicating where the mud fluid was placed and the method or methods used in introducing it into the hole. If cement or other plugs were used, state the character of same and depth placed, from _____ feet to _____ feet for each plug set.

3737' - 3700' - SAND
3700' - 3660' - 5 SACKS CEMENT
3600' - 300' - MUD
300' - 290' - ROCK BRIDGE
290' - 215' - 25 SACKS CEMENT
215' - 40' - MUD
40' - 30' - ROCK BRIDGE
30' - BASE - 10 SACKS CEMENT

APR 11 1966
RECEIVED BY CONSERVATION DIVISION
WICHITA, KANSAS

(If additional description is necessary, use BACK of this sheet)

Name of Plugging Contractor SANTA-FE PIPE & SUPPLY, INC.
Address P. O. BOX 562, GREAT BEND, KANSAS

STATE OF KANSAS, COUNTY OF BARTON, ss.
T. L. NUTT (employee of owner) or (owner or operator) of the above-described

well, being first duly sworn on oath, says: That I have knowledge of the facts, statements, and matters herein contained and the log of the above-described well as filed and that the same are true and correct. So help me God.

(Signature) T. L. Nutt

P. O. BOX 562, GREAT BEND, KANSAS
(Address)

SUBSCRIBED AND SWORN TO before me this 25th day of MARCH, 1966

My commission expires JULY 31, 1966

Mary M. Swanson
Notary Public.

KANSAS WELL LOG BUREAU --- KANSAS GEOLOGICAL SOCIETY
508 EAST MURDOCK - WICHITA, KANSAS

COMPANY GULF OIL CORP.

SEC. 7 T. 21 R. 14W

FARM Hullmann

NO. 2

LOC. ONE NW SW

TOTAL DEPTH 3737

COUNTY Stafford


COMM. 3-2-51

COMP. 3-21-51

SHOT OR TREATED Acidized w/100 gals.

CONTRACTOR

ISSUED 5-12-51

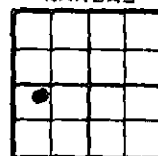

CASINO

8 5/8" 906' cem. w/365 sx
5 1/2" 3734' 6" cem. w/50 sx

ELEVATION 1936

PRODUCTION 152.19 BO
/ 1.53 wtr

FIGURES INDICATE BOTTOM OF FORMATIONS

sand clay & gravel	155
shale	330
sand	400
shale & red bed	510
shale	650
sand	680
shale & red bed	898
anhydrite	935
red bed & shale	1355
shale	1665
shale & shells	2020
shale & lime	2135
lime & shale	2465
shale	2710
lime & shale	2745
lime	2820
lime & shale	2925
shale & lime	3030
lime	3095
shale & lime	3155
lime	3260
lime & shale	3320
lime	3658
cherty viola lime	3685
shale & lime	3737
Total Depth	

Tops:	
Heebner	3274
Toronto	3286
Base Oread	3304
Brown Lime	3474
Lansing	3483
Viola	3638
Simpson	3685
Arbuckle	3733

RECEIVED
STATE CORPORATION COMMISSION
APR 11 1966
CONSERVATION DIVISION
Wichita, Kansas