

STATE OF KANSAS
STATE CORPORATION COMMISSION

Give All Information Completely
Make Required Affidavit
Mail or Deliver Report to:
Conservation Division
State Corporation Commission
212 North Market, Insurance Bldg.
Wichita, Kansas

WELL PLUGGING RECORD

Stafford County, Sec. 7 Twp. 21S Rge. 14W (E) (W)

Location as "NE/CNW%SW%" or footage from lines C SW/NW

Lease Owner Sinclair Oil & Gas Company

Lease Name Olive Opie Well No. 3

Office Address Tulsa, Oklahoma

Character of Well (completed as Oil, Gas or Dry Hole) Oil

Date well completed 2-3-51 19

Application for plugging filed 1-16-61 19

Application for plugging approved 1-17-61 19


Plugging commenced 4-28-61 19

Plugging completed 5-1-61 19

Reason for abandonment of well or producing formation Exhausted oil well - Unprofitable to operate

If a producing well is abandoned, date of last production 12-1-55 19

Was permission obtained from the Conservation Division or its agents before plugging was commenced? Yes

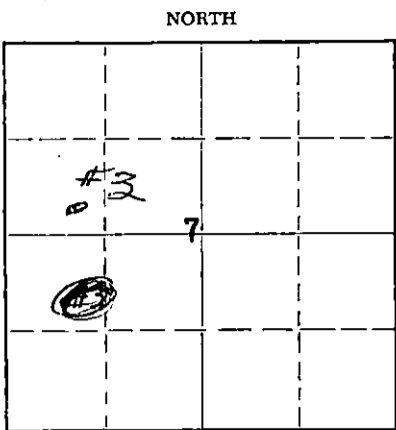

Locate well correctly on above Section Plat

Name of Conservation Agent who supervised plugging of this well Frank Broadfoot

Producing formation Arbuckle Depth to top 3725' Bottom 3733' Total Depth of Well 3733' Feet

Show depth and thickness of all water, oil and gas formations.

OIL, GAS OR WATER RECORDS

CASING RECORD

FORMATION	CONTENT	FROM	TO	SIZE	PUT IN	PULLED OUT
Arbuckle Lime	Oil	3725	2733'	8-5/8"	905'	None
				5 1/2"	3724'	3260'

Describe in detail the manner in which the well was plugged, indicating where the mud fluid was placed and the method or methods used in introducing it into the hole. If cement or other plugs were used, state the character of same and depth placed, from _____ feet to _____ feet for each plug set.

Sanded bottom 3733' to 3710', 5 sacks cement from 3710 to 3675' Mudded from 3675' to 260', rock bridge from 260 to 250', 20 sacks cement from 250 to 190', mud from 190 to 40', frock bridge from 40 to 30' 10 sacks cement from 30' to surface - Completed P&A at 4:PM 5-1-61.

RECEIVED
STATE CORPORATION COMMISSION
MAY 24 1961
CONSERVATION DIVISION
Wichita, Kansas

(If additional description is necessary, use BACK of this sheet)
Name of Plugging Contractor Knight Casing Pulling Company
Address Chase, Kansas

STATE OF Kansas COUNTY OF Rice, ss.
C. E. Most (employee of owner) or (owner or operator) of the above-described

well, being first duly sworn on oath, says: That I have knowledge of the facts, statements, and matters herein contained and the log of the above-described well as filed and that the same are true and correct. So help me God.

(Signature) C. E. Most, Dist. Supt.
Box 466, Chase, Kansas (Address)

SUBSCRIBED AND SWORN TO before me this 22nd day of May, 19 61

My commission expires August 13, 1962 L. B. Reynolds Notary Public.

15.195.01860.0000

COPY OF DRILLER'S LOG

Sinclair Oil & Gas Company
Olive Opie # 3
Sec. 7-21S-14W
Stafford County, Kansas

Contractor;
Harbar Drlg. Co.
Wichita, Kansas

GEOLOGICAL TOPS FROM ELECTRIC LOG

Anhydrite	900'
Lanxing KC	3378
Conglomerate	3632
Viola	3634
Simpson	3679
Arbuckle	3725'
Total Depth	3733'

Surface Casing;

900' of 8-5/8" set at 900'
Cemented with 1100 sacks

Date drilling commenced 19-19-51
Drilling completed 2-3-51

Oil string;
3726' of 5 1/2" set at 3726'
cemented with 75 sacks.

RECEIVED
STATE CORPORATION COMMISSION
MAY 24 1961
CONSERVATION DIVISION
Wichita, Kansas