


Give All Information Completely
Make Required Affidavit
Mail or Deliver Report to:
Conservation Division
State Corporation Commission
212 North Market, Insurance Bldg.
Wichita, Kansas

WELL PLUGGING RECORD

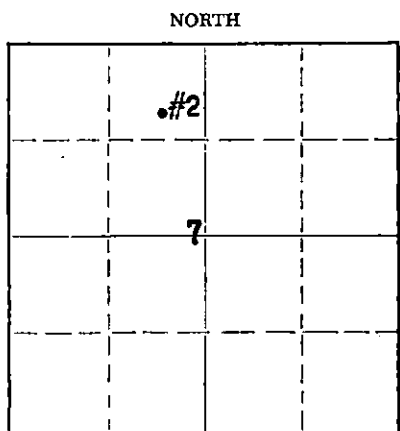

Locate well correctly on above Section Plat

Stafford County. Sec. 7 Twp. 21S Rge. 14W (E) (W)
Location as "NE/CNW/SW" or footage from lines C - NE/NW
Lease Owner Sinclair Oil & Gas Company
Lease Name Olive Opie Well No. 2
Office Address Tulsa, Oklahoma
Character of Well (completed as Oil, Gas or Dry Hole) Oil Well
Date well completed 12-31-50 19
Application for plugging filed 1-16-61 19
Application for plugging approved 1-17-61 19
Plugging commenced 5-5-61 19
Plugging completed 5-7-61 19
Reason for abandonment of well or producing formation Depleted oil well
Unprofitable to operate
If a producing well is abandoned, date of last production 4-1-61 19
Was permission obtained from the Conservation Division or its agents before plugging was commenced? Yes

Name of Conservation Agent who supervised plugging of this well Frank Broadfoot
Producing formation Arbuckle Depth to top 3703 Bottom 3711' Total Depth of Well 3711 Feet
Show depth and thickness of all water, oil and gas formations.

OIL, GAS OR WATER RECORDS

CASING RECORD

FORMATION	CONTENT	FROM	TO	SIZE	PUT IN	PULLED OUT
<u>Arbuckle Lime</u>	<u>Oil</u>	<u>3703</u>	<u>3711</u>	<u>10-3/4"</u> <u>5 1/2"</u>	<u>896'</u> <u>3702'</u>	<u>None</u> <u>2711'</u>

Describe in detail the manner in which the well was plugged, indicating where the mud fluid was placed and the method or methods used in introducing it into the hole. If cement or other plugs were used, state the character of same and depth placed, from _____ feet to _____ feet for each plug set.

Sanded from TD 3711' to 3690' - Dumped 5 sacks cement from 3690' to 3655' with dump bailer. Mudded hole from 3655' to 260', set 10' rock bridge from 260 to 250', 20 sacks cement from 250' to 200', Mudded from 200' to 35' 10' rock bridge from 35' to 25', 10 sacks cement from 25' to surface. Completed P&A at 4:PM 5-7-61 - Plugged as per state ~~sin~~ Inspector's instructions.

RECEIVED 5-24-1961
STATE CORPORATION COMMISSION
MAY 24 1961
CONSERVATION DIVISION
Wichita, Kansas

(If additional description is necessary, use BACK of this sheet)
Name of Plugging Contractor Knight Casing Pulling Company
Address Chase, Kansas

STATE OF Kansas, COUNTY OF Rice, ss. C.E. Most (employee of owner) or (owner or operator) of the above-described well, being first duly sworn on oath, says: That I have knowledge of the facts, statements, and matters herein contained and the log of the above-described well as filed and that the same are true and correct. So help me God.

(Signature) C.E. Most Dist. Supt.
Box 466, Chase, Kansas
(Address)

SUBSCRIBED AND SWORN TO before me this 22nd day of May, 19 61

My commission expires 8-13-62 L. B. Reynolds Notary Public.

15.195.01859.0000

COPY OF DRILLERS LOG

Sinclair Oil & Gas Company
Olive Opie # 2
Sec. 7-21S-11W
Stafford County, Kansas

Contractor;
Harbar Drlg. Co.
Wichita, Kansas

GEOLOGICAL TOPS FROM ELECTRIC LOG

Lansing - KC	3365
Conglomerate	3616
Viola	3619
Simpson	3655
Arbuckle	3703
Total Depth	3711'

Surface Casing
896' of 10-3/4" set at 896'
Cemented with 800 sacks

Date drilling commenced 12-12-50
Drilling completed 12-31-50

Oil string;
3702' of 5 1/2" set at 3702'
Cemented with 175 sacks.

RECEIVED
STATE CORPORATION COMMISSION

MAY 24 1961

CONSERVATION DIVISION
Wichita, Kansas