

STATE OF KANSAS  
STATE CORPORATION COMMISSION


WELL PLUGGING RECORD

OR  
FORMATION PLUGGING RECORD

Strike out upper line when reporting plugging of formations.

Give All Information Completely  
Make Required Affidavit  
Mail or Deliver Report to:  
Conservation Division  
State Corporation Commission  
800 Bitting Building  
Wichita, Kansas

Stafford County. Sec. 7 Twp. 21 Rge. 11 (W)  
Location as "NE1/4NW1/4SW1/4" or footage from lines C-NW NW SE  
Lease Owner Sunray Oil Corporation  
Lease Name M. F. Russell Well No. 1  
Office Address Box 195, Great Bend, Kansas  
Character of Well (completed as Oil, Gas or Dry Hole) Dry Hole  
Date well completed 9-29 19 50  
Application for plugging filed 10-2 19 50  
Application for plugging approved 10-3 19 50  
Plugging commenced 11-10 19 50  
Plugging completed 11-10 19 50  
Reason for abandonment of well or producing formation Dry Hole

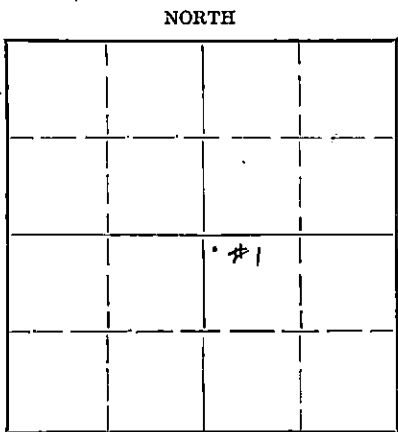

Locate well correctly on above Section Plat

If a producing well is abandoned, date of last production 19  
Was permission obtained from the Conservation Division or its agents before plugging was commenced? Yes  
Name of Conservation Agent who supervised plugging of this well C. D. Stough  
Producing formation Depth to top Bottom Total Depth of Well 3770' Feet  
Show depth and thickness of all water, oil and gas formations.

OIL, GAS OR WATER RECORDS

CASING RECORD

Formation	Content	From	To	Size	Put In	Pulled Out
Lansing-KC	Water	3388	3636	8-5/8"	911'	None
Arbuckle	Water & Oil	3726		5 1/2"	3728'	3013'

Describe in detail the manner in which the well was plugged, indicating where the mud fluid was placed and the method or methods used in introducing it into the hole. If cement or other plugs were used, state the character of same and depth placed, from feet to feet for each plug set.

Filled w/crushed rocks from total depth (3770) to bottom 5 1/2" casing (3728), dumped 5 sax cement. Filled with mud to 250', dumped 20 sax cement, filled with mud to 30', dumped 10 sax cement, mud to surface.

RECEIVED  
STATE CORPORATION COMMISSION  
DEC-1-1950  
CONSERVATION DIVISION  
Wichita, Kansas

(If additional description is necessary, use BACK of this sheet)  
Correspondence regarding this well should be addressed to Sunray Oil Corporation  
Address Box 195, Great Bend, Kansas

STATE OF KANSAS, COUNTY OF BARTON, SS.  
H. S. Mann (employee of owner) of the above-described well,

being first duly sworn on oath, says: That I have knowledge of the facts, statements, and matters herein contained and the log of the above-described well as filed and that the same are true and correct. So help me God.

(Signature) H. S. Mann Engineer

Box 195, Great Bend, Kansas (Address)

SUBSCRIBED AND SWORN to before me this 30th day of November, 1950

Martha Scott Notary Public

My commission expires April 19, 1952.

PLUGGING  
FILE SEC 7 T 21 R 14W  
BOOK PAGE 32 LINE 28

KANSAS WELL LOG BUREAU --- KANSAS GEOLOGICAL SOCIETY

508 EAST MURDOCK - WICHITA, KANSAS

COMPANY Sunrat Oil Corp.

SEC. 7 T. 21 R. 11W

FARM M. F. Russell

NO. 1

LOC. NW NW SE

TOTAL DEPTH 3733

COUNTY Stafford


COMM. 9-4-50

COMP. 9-21-50

SHOT OR TREATED

CONTRACTOR Murfin Drilling Co.

ISSUED

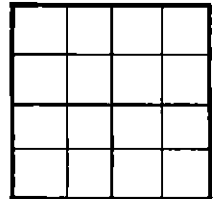

CASING

20	10	
15%	8 1/4	912
12%	6%	
13%	5 1/4	3731

ELEVATION

PRODUCTION

FIGURES INDICATE BOTTOM OF FORMATIONS

320 sand-shale  
 415 sand  
 520 red bed  
 670 red bed shale & shells  
 888 shale-shells  
 914 anhydrite  
 1000 shale-shells  
 1140 shale, salt, shells  
 1725 shale-shells  
 2090 lime  
 2200 lime-shale  
 2310 lime  
 2810 shale-lime  
 2820 lime  
 3025 shale-lime  
 3285 lime  
 3405 lime-shale  
 3605 lime  
 3685 lime-shale  
 3705 shale  
 3733 T.D.

STATE OF KANSAS )  
 ) SS:  
 SEDGWICK COUNTY)

I, W. R. Murfin, of the Murfin Drilling Co., upon oath state that the above and foregoing is a true and correct copy of the log of the M. F. Russell No. 1 well.

*W. R. Murfin*  
 \_\_\_\_\_  
 W. R. Murfin

Subscribed and sworn to before me this 12th day of October, 1950.

*Genevieve Hays*  
 \_\_\_\_\_  
 Notary Public

My Commission Expires: 3-5-52

RECEIVED  
 STATE CORPORATION COMMISSION

DEC 1 - 1950

CONSERVATION DIVISION  
 Wichita, Kansas

PLUGGING  
 FILE SEC 7 T 21 R 11W  
 BOOK PAGE 32 LINE 28