

STATE OF KANSAS  
STATE CORPORATION COMMISSION


WELL PLUGGING RECORD

Give All Information Completely  
Make Required Affidavit  
Mail or Deliver Report to:  
Conservation Division  
State Corporation Commission  
808 Bitting Building  
Wichita, Kansas

Stafford County, Sec. 7 Twp. 21 Rge. (E) 14 (W)

Location as "NE/CNW/SW" or footage from lines NE NW SE  
Lease Owner Graham-Messman-Rinehart Oil Company  
Lease Name Russell Well No. 1  
Office Address P. O. Box 1033, Wichita, Kansas  
Character of Well (completed as Oil, Gas or Dry Hole) Dry Hole  
Date well completed January 23, 19 53  
Application for plugging filed January 23, 19 53  
Application for plugging approved January 26, 19 53  
Plugging commenced January 23, 19 53  
Plugging completed January 23, 19 53  
Reason for abandonment of well or producing formation Dry hole

NORTH

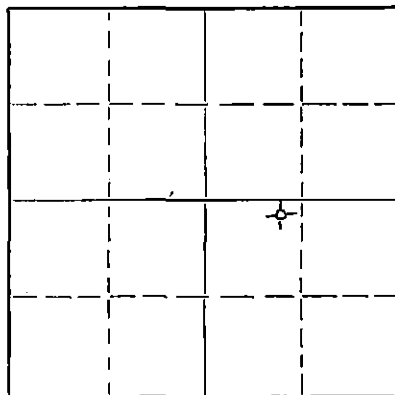

Locate well correctly on above  
Section Plat

If a producing well is abandoned, date of last production \_\_\_\_\_ 19 \_\_\_\_  
Was permission obtained from the Conservation Division or its agents before plugging was commenced? yes

Name of Conservation Agent who supervised plugging of this well M. A. Rives, Box 148, Pratt, Kansas  
Producing formation \_\_\_\_\_ Depth to top \_\_\_\_\_ Bottom \_\_\_\_\_ Total Depth of Well 3760 Feet  
Show depth and thickness of all water, oil and gas formations.

OIL, GAS OR WATER RECORDS

CASING RECORD

FORMATION	CONTENT	FROM	TO	SIZE	PUT IN	PULLED OUT
				8 5/8	891'	none

Describe in detail the manner in which the well was plugged, indicating where the mud fluid was placed and the method or methods used in introducing it into the hole. If cement or other plugs were used, state the character of same and depth placed, from \_\_\_\_\_ feet to \_\_\_\_\_ feet for each plug set.

First plug @ 300' w/20 sk.  
cement. Top plug @ 35' w/10 sk.  
cement. Mud to surface.

2-13-53

(If additional description is necessary, use BACK of this sheet)  
Name of Plugging Contractor Graham-Messman-Rinehart Oil Company,  
Address P. O. Box 1033, Wichita, Kansas

STATE OF Kansas, COUNTY OF Sedgwick, ss.  
J. A. Gilliland (employee of owner) ~~OR OWNER OR OPERATOR~~ of the above-described well, being first duly sworn on oath, says: That I have knowledge of the facts, statements, and matters herein contained and the log of the above-described well as filed and that the same are true and correct. So help me God.

**PLUGGING**  
FILE SEC 7-121-142  
BOOK 25 PAGE 5

(Signature) J. A. Gilliland  
P. O. Box 1033, Wichita, Kansas  
(Address)

SUBSCRIBED AND SWORN-TO before me this 12th day of February, 19 53

My commission expires December 1, 1956

Barbara J. Scott  
Notary Public.

RUSSELL # 1

WELL RECORD

Location:	NE-NW-SE Sec. 7-21-14W Stafford County, Kansas	Commenced:	January 11, 1953
Operator:	G-M-R Oil Company	Completed:	January 23, 1953
Contractor:	G-M-R Oil Company	Production:	D. & A.
Casing Record:	8 5/8" @891 w/400 ex. cement	Elevation:	1943 K.B.

L-O-G

Sand & Clay	162
Shale & Clay	242
Shale & Clay	320
Sand	418
Shale & Clay	627
Shale & Shells	850
Shale	888
Anhydrite	891
Anhydrite	912
Shale	1111
Shale	1490
Shale	1625
Shale & Lime	1835
Shale & Lime	1905
Shale & Lime	1928
Lime	1964
Shale & Lime	2120
Shale & Lime	2245
Shale & Lime	2420
Shale & Lime	2550
Shale & Lime	2650
Shale & Lime	2825
Shale & Lime	2931
Lime & Shale	3060
Lime & Shale	3160
Lime & Shale	3216
Lime & Shale	3270
Lime & Shale	3335
Lime & Shale	3408
Brown Lime	3435
Lime & Shale	3495
Lime	3540
Lime	3595
Lime & Shale	3672
Lime & Shale	3688
Lime & Shale	3708
Lime & Shale	3722
Arbuckle	3730
Lime	3750
Arbuckle	3760 T.D.

TOPS

Heebner	3274 (-1331)
Douglas	3307 (-1364)
Brown Lime	3376 (-1433)
Lansing	3388 (-1445)
Conglomerate	3640 (-1703)
Viola	3646 (-1703)
Arbuckle	3722 (-1779)

RECEIVED  
 DEPARTMENT OF REVENUE  
 FEB 1 1953  
 CONSERVATION DEPARTMENT  
 Wichita, Kansas

The undersigned, GRAHAM-Messman-Rinehart Oil Company, hereby certifies that the above log is a true and correct log of the formations encountered in drilling the above well as reflected by the Daily Drilling Reports.

**PLUGGING**  
 PER SEC 7-21-14W  
 BOOK PAGE 25 LINE 5

GRAHAM-MESSMAN-RINEHART OIL COMPANY

By J. A. Gilliland  
 J. A. Gilliland

Subscribed and sworn to before me this 27th day of January, 1953.

Richard J. Scott  
 Notary Public

My Commission expires: December 1, 1956