


Give All Information Completely
Make Required Affidavit
Mail or Deliver Report to:
Conservation Division
State Corporation Commission
211 No. Broadway
Wichita, Kansas

WELL PLUGGING RECORD

Stafford County. Sec. 7 Twp. 21 Rge. (EX 14) (W)
Location as "NE/CNW4SW4" or footage from lines. NE NW NE
Lease Owner National Cooperative Refinery Association
Lease Name Frey "A" Well No. 4
Office Address P. O. Box 6, Great Bend, Kansas 67530
Character of Well (completed as Oil, Gas or Dry Hole) Oil
Date well completed December 29 1950
Application for plugging filed September 7 1965
Application for plugging approved September 8 1965
Plugging commenced September 10 1965
Plugging completed September 13 1965
Reason for abandonment of well or producing formation depletion in Lansing.

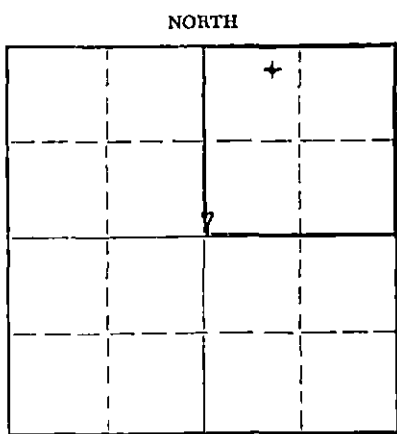

Locate well correctly on above Section Plat

If a producing well is abandoned, date of last production August 1965
Was permission obtained from the Conservation Division or its agents before plugging was commenced? Yes

Name of Conservation Agent who supervised plugging of this well A. Elving, Box 248, Pratt, Kansas.
Producing formation Lansing Depth to top 3438' Bottom 3531' Total Depth of Well 3710' Feet
Show depth and thickness of all water, oil and gas formations.

OIL, GAS OR WATER RECORDS CASING RECORD

FORMATION	CONTENTS	TO	SIZE	PUT IN	PULLED OUT
	RECEIVED	STATE CORPORATION COMMISSION	8 5/8"	881'	None
			5 1/2"	3695'	3251'
	SEP 20 1965				
	CONSERVATION DIVISION				
	Wichita, Kansas				

Describe in detail the manner in which the well was plugged, indicating where the mud fluid was placed and the method or methods used in introducing it into the hole. If cement or other plugs were used, state the character of same and depth placed, from _____ feet to _____ feet for each plug set.

Sanded back from 3710' to 3680', dumped 5 sxs. cement; shot pipe @ 3228'.
Spotted 40 bbls. oil; pulled 110 joints of 5 1/2" casing. Mudded hole to 300'; set 15' rock bridge; dumped 3 1/2 yards ready mix cement to surface.

(If additional description is necessary, use BACK of this sheet)
Name of Plugging Contractor Ralph Comstock Pipe Pulling, Inc.
Address 411 South Buckeye, Stafford, Kansas

STATE OF KANSAS, COUNTY OF BARTON, ss.
Joe Hertel (employee of owner) or (owner or operator) of the above-described well, being first duly sworn on oath, says: That I have knowledge of the facts, statements, and matters herein contained and the log of the above-described well as filed and that the same are true and correct. So help me God.

(Signature) Joe Hertel
P. O. Box #6, Great Bend, Kansas
(Address)

SUBSCRIBED AND SWORN TO before me this 17th day of September, 1965.

My commission expires October 23, 1966.
Irene Kelly Marney Notary Public.

THE VICKERS PETROLEUM CO., INC.

Frey Well #4
NE NW NE Sec. 7-21S-14W
Stafford County, Kansas

Casing Record:
8-5/8" @ 881' w/420 sx
5-1/2" @ 3695' w/75 sx

Commenced: November 16, 1950
Completed: December 21, 1950

Elevation: 1929 R.B. 1887
Potential Drawdown 1880 BOPD
No water

LOG

Surface & Sand	0-280
Shale & Sand	280-305
Sand	305-415
Shale Sand & Red Bed	415-780
Shale & Red Bed	780-876
Anhydrite	876-900
Red Bed, Shale & Shells	900-1350
Salt, Shale, & Shells	1350-1415
Shale & Salt	1415-1600
Broken Lime	1600-1870
Broken Lime & Sand	1870-2090
Broken Lime	2090-2177
Lime & Shale	2177-2795
Lime	2795-3110
Lime & Shale	3110-3284
Shale	3284-3356
Lime & Shale	3356-3618
Chert	3618-3650
Shale	3650-3694
Dolomite	3694-3698 RTD

Cable Tools:

Clean out & Drill Deeper 3698-3701
Swab 1 1/2 BOPH 1 hr.
Drl. Deeper 3701-3703, No increase
Drl. Deeper 3703-3705 1/2
Fill up 15 hrs. 3250' oil
Swab 15 BOPH for 2 hrs.
Drl. Deeper 3705 1/2-3707 1/2, no increase
Drl. Deeper 3707 1/2-3710 T.D.
Swab 20 BOPH for 2 hrs.
Run tubing and rod, acidize w/2000 gal.

Tops:

Heebner	3257
Brown Lime	3356
Lansing	3367
Viola	3618
Simpson	3650
Arbuckle	3694

I hereby certify that this log is true and correct to the best of my knowledge and belief.

THE VICKERS PETROLEUM CO., INC.

By *W. P. Summers*

Sworn and subscribed to before me
this 5th day of January, 1951.

Allen J. Denton
Notary Public

My commission expires Aug. 13, 1953.

RECEIVED
STATE CORPORATION COMMISSION
SEP 20 1965
CONSERVATION DIVISION
Wichita, Kansas