


Give All Information Completely
Make Required Affidavit
Mail or Deliver Report to:
Conservation Division
State Corporation Commission
211 No. Broadway
Wichita, Kansas

WELL PLUGGING RECORD

Stafford County, Sec. 7 Twp. 21 Rge. (E) 14 (W)

Location as "NE/CNW/SW" or footage from lines NE SW NE
Lease Owner National Cooperative Refinery Association
Lease Name Frey "A" Well No. 2
Office Address P. O. Box 6, Great Bend, Kansas
Character of Well (completed as Oil, Gas or Dry Hole) Oil
Date well completed November 11, 19 50
Application for plugging filed July 11, 19 66
Application for plugging approved July 12, 19 66
Plugging commenced July 23, 19 66
Plugging completed July 25, 19 66
Reason for abandonment of well or producing formation Depletion

NORTH

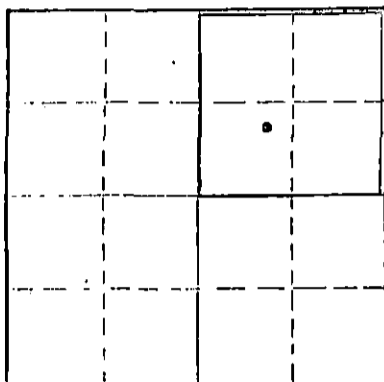

Locate well correctly on above Section Plat

If a producing well is abandoned, date of last production June 10 19 66
Was permission obtained from the Conservation Division or its agents before plugging was commenced? Yes

Name of Conservation Agent who supervised plugging of this well A. Elving
Producing formation Arbuckle Depth to top 3710 Bottom 3728 Total Depth of Well 3728 Feet
Show depth and thickness of all water, oil and gas formations.

OIL, GAS OR WATER RECORDS

CASING RECORD

FORMATION	CONTENT	FROM	TO	SIZE	PUT IN	PULLED OUT
				8 5/8"	890'	None
				5 1/2"	3716'	437'

Describe in detail the manner in which the well was plugged, indicating where the mud fluid was placed and the method or methods used in introducing it into the hole. If cement or other plugs were used, state the character of same and depth placed, from _____ feet to _____ feet for each plug set.

Sanded hole from 500' to 490', dumped 5 sacks cement. Shot 5 1/2" casing off @ 437'. Pulled 437' 5 1/2" casing. Set rock bridge from 300' to 290'. Dumped 4 yards ready-mix concrete on up to base of cellar.

RECEIVED
STATE CORPORATION COMMISSION

JUL 26 1966

CONSERVATION DIVISION
WICHITA, KANSAS

(If additional description is necessary, use BACK of this sheet)
Name of Plugging Contractor Ralph Comstock Casing Pulling Company
Address Stafford, Kansas

STATE OF KANSAS COUNTY OF BARTON
Joe Hertel (employee of owner) / ss. of the above-described well, being first duly sworn on oath, says: That I have knowledge of the facts, statements, and matters herein contained and the log of the above-described well as filed and that the same are true and correct. So help me God.

(Signature) Joe Hertel
Joe Hertel
Box 6, Great Bend, Kansas 67530
(Address)

SUBSCRIBED AND SWORN to before me this 25th day of July, 19 66

My commission expires October 23, 1966

Irene Kelly Marney
Irene Kelly Marney Notary Public.

THE VICKERS PETROLEUM CO., INC.

Frey Well #2
NE SW NE Sec. 7-21S-14W
Stafford County, Kansas

Commenced: October 18, 1950
Completed: November 11, 1950

Casing Record:
8-5/8" @ 890' w/400' sx
5-1/2" @ 3716' w/75' sx

Elevation: 1934 R.B.
Potential: Echometer 3128 B&PD
Trace Water

LOG

Surface Sand & Soil	0-240
Shale, Shells, & Sand	240-325
Sand	325-440
Shale, Sand & Red Bed	440-555
Red Bed & Shale	555-880
Red Bed	880-885
Anhydrite	885-910
Shale & Red Bed	910-1090
Shale & shells	1090-1375
Shale, Salt & Shells	1375-1610
Shale & Lime	1610-1815
Lime & Shale	1815-1930
Bro. Lime & Sand	1930-2065
Lime	2065-2155
Lime & Shale	2155-2975
Lime	2975-3295
Shale	3295-3363
Lime & Shale	3363-3628
Chert	3628-3664
Shale	3664-3710
Dolomite	3710-3726 R.T.D.

DST 3714-3726. Open 15 min. Good strong blow.
Recovered 520' Fluid (400' oil + 120' heavily
oil cut mud). B.H.P. 1000#

Cable Tools:
Clean out to 3726
Fill up 14 hrs. 3250' oil
Drill deeper to 3728 T.D.
Acidize 2000 gal. Put on pump.

Tops:	
Heebner	3261
Brown Lime	3363
Lansing	3873 3373
Viola	3628
Simpson	3664
Arbuckle	3710

RECEIVED
STATE CORPORATION COMMISSION

JUL 26 1966

CONSERVATION DIVISION
Wichita, Kansas

I hereby certify that this log is true and correct to the best of my
knowledge and belief.

The Vickers Petroleum Co., Inc.

By: *W. P. Sammons*

Sworn and subscribed to before me
this 16th day of November, 1950.

Allen P. Denton
Notary Public

My commission expires Aug. 13, 1953.