


WELL PLUGGING RECORD

Give All Information Completely
Make Required Affidavit
Mail or Deliver Report to:
Conservation Division
State Corporation Commission
211 No. Broadway
Wichita, Kansas

NORTH

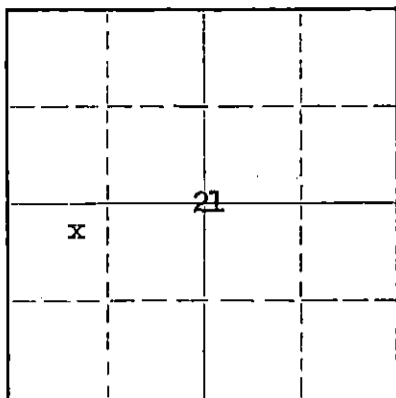

Locate well correctly on above Section Plat

Stafford County. Sec. 9 Twp. 21 Rge. 14 (B) (W)
Location as "NE/CNWSW" or footage from lines NE NW SW
Lease Owner WILKINSON DRILLING, INC.
Lease Name HULLETT Well No. 1
Office Address 1121 Union National Building, Wichita 2, Kansas
Character of Well (completed as Oil, Gas or Dry Hole) Dry Hole
Date well completed July 21, 1958
Application for plugging filed July 21, 1958
Application for plugging approved July 21, 1958
Plugging commenced July 21, 1958
Plugging completed July 21, 1958
Reason for abandonment of well or producing formation No commercial quantity of oil and/or gas was encountered.
If a producing well is abandoned, date of last production - 19
Was permission obtained from the Conservation Division or its agents before plugging was commenced? Yes

Name of Conservation Agent who supervised plugging of this well M. A. Rives
Producing formation - Depth to top - Bottom - Total Depth of Well - Feet
Show depth and thickness of all water, oil and gas formations.

OIL, GAS OR WATER RECORDS

CASING RECORD

FORMATION	CONTENT	FROM	TO	SIZE	PUT IN	PULLED OUT
Sand	Water	50	80			
Sand	Water	150	190			

Describe in detail the manner in which the well was plugged, indicating where the mud fluid was placed and the method or methods used in introducing it into the hole. If cement or other plugs were used, state the character of same and depth placed, from - feet to - feet for each plug set.

Filled hole with heavy mud. Plugged at 240' with 1/4 sack hulls and 20 sacks cement. Mud to 35'. Plugged at 35'. Topped with 1/2 sack hulls and 10 sacks cement.

(If additional description is necessary, use BACK of this sheet)

Name of Plugging Contractor WILKINSON DRILLING, INC.
Address 1121 Union National Building, Wichita 2, Kansas

STATE OF Kansas, COUNTY OF Sedgwick, ss.
Walter M. Wilkinson (employee of/owner)/or (owner or operator) of the above-described well, being first duly sworn on oath, says: That I have knowledge of the facts, statements, and matters herein contained and the log of the above-described well as filed and that the same are true and correct. So help me God.

(Signature) Walter M. Wilkinson
1121 Union National Bldg., Wichita, Kansas
(Address)

SUBSCRIBED AND SWORN to before me this 31st day of July, 1958

My commission expires January 2, 1961

Carolyn F. Moore
RECEIVED Notary Public.
STATE CORPORATION COMMISSION

PLUGGING
FILE SEC. 9 T. 21 R. 14w
BOOK PAGE 119 LINE 2

AUG 5 1958
8-5-1958
CONSERVATION DIVISION

WILKINSON DRILLING, INC.
 1121 Union National Building
 Wichita 2, Kansas

July 30, 1958

HULLETT NO. 1

Company	- WILKINSON DRILLING, INC.	Location	- NE NW SW, 9-21s-14w, Stafford County, Kansas
Contractor	- Company Tools	Elevation	- 1940' KB
Commenced	- July 15, 1958	Casing	- 8 5/8" @ 331' w/200 sks Cmn Cem
Completed	- July 21, 1958		
Total Depth	- 3600'		

FIGURES INDICATE BOTTOMS OF FORMATIONS

<u>Depth</u>	<u>Formation</u>
0 - 200	Shale and Sand Streaks
200 - 331	Shale
331 - 870	Shale and Red Beds
870 - 895	ANHYDRITE
895 - 1740	Shale and Shells
1740 - 3230	Lime and Shale
3230 - 3332	Shale and Lime
3332 - 3545	Lime
3545 - 3562	Shale
3562 - 3600	Cherty Dolomite and Chert

We hereby certify the above and foregoing to be a true and correct copy of the Log on the Hullett No. 1, located in the NE NW SW, 9-21s-14w, Stafford County, Kansas.

WILKINSON DRILLING, INC.

Walter M. Wilkinson

Subscribed and sworn to before me this twenty-ninth day of July, nineteen hundred and fifty-eight.

Carolyn K. Moore

My Commission expires January 2, 1961.

RECEIVED
 STATE CORPORATION COMMISSION

PLUGGING	
FILE SEC	9 T 21 R 14 W
BOOK PAGE	119 LINE 2

AUG 1 1958
 CONSERVATION DIVISION
 Wichita, Kansas