


WELL PLUGGING RECORD

Give All Information Completely
Make Required Affidavit
Mail or Deliver Report to:
Conservation Division
State Corporation Commission
211 No. Broadway
Wichita, Kansas

NORTH

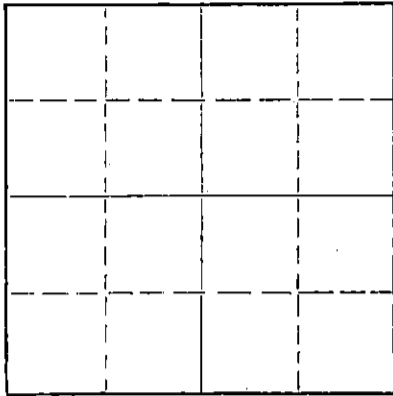

Locate well correctly on above
Section Plat

Stafford County, Sec. 9 Twp. 21SRge. 14W(E) (W)
Location as "NE/CNW%SW%" or footage from lines NW SW NW
Lease Owner ALPINE OIL & ROYALTY CO., INC.
Lease Name ASHER Well No. 1
Office Address 800 Bitting Building, Wichita, Kansas
Character of Well (completed as Oil, Gas or Dry Hole) dry hole
Date well completed February 16, 1963 19
Application for plugging filed February 16, 1963 19
Application for plugging approved February 16, 1963 19
Plugging commenced February 16, 1963 19
Plugging completed February 16, 1963 19
Reason for abandonment of well or producing formation non-productive in commercial quantities
If a producing well is abandoned, date of last production 19
Was permission obtained from the Conservation Division or its agents before plugging was commenced? yes

Name of Conservation Agent who supervised plugging of this well Archie Elving
Producing formation _____ Depth to top _____ Bottom _____ Total Depth of Well 3670 Feet
Show depth and thickness of all water, oil and gas formations.

OIL, GAS OR WATER RECORDS

CASING RECORD

FORMATION	CONTENT	FROM	TO	SIZE	PUT IN	PULLED OUT
				8 5/8"	260'	cemented

Describe in detail the manner in which the well was plugged, indicating where the mud fluid was placed and the method or methods used in introducing it into the hole. If cement or other plugs were used, state the character of same and depth placed, from _____ feet to _____ feet for each plug set.

Heavy mud from total depth 3670 to 180 feet
1/4th sacks hulls, plug 20 sacks cement
through drill pipe, mud to 35 feet, 1/4th
sack hulls plug and 10 sacks cement
2 sacks cement in rat hole.

RECEIVED
STATE CORPORATION COMMISSION

MAR 26 1963

CONSERVATION DIVISION
Wichita, Kansas

3-26-1963

(If additional description is necessary, use BACK of this sheet)

Name of Plugging Contractor Quaker Drilling Co., Inc.
Address 800 Bitting Building, Wichita, Kansas

STATE OF Kansas, COUNTY OF Sedgwick, ss.
Thomas M. McCaul (employee of owner) or (owner or operator) of the above-described

well, being first duly sworn on oath, says: That I have knowledge of the facts, statements, and matters herein contained and the log of the above-described well as filed and that the same are true and correct. So help me God.

(Signature) Thomas M. McCaul
800 Bitting Bldg., Wichita, Ks.
(Address)

SUBSCRIBED AND SWORN TO before me this 25th day of February, 1963

My commission expires August 10, 1965

Reginald H. ...
Notary Public.



WELL LOG

ALPINE OIL & ROYALTY CO., INC.

Commenced: February 5, 1963

Contractor: Quaker Drilling Co., Inc.

Completed: February 16, 1963

Asher No. 1
NW SW NW Section 9-21S-14W
Stafford County, Kansas

Elevation: 1941 K. B.

Production: D. & A.

Casing Record

Set 8 5/8 inch casing at 260 feet with 315 sacks cement

(Figures Indicate the Bottom of the Formations)

<u>FORMATION</u>	<u>DEPTH</u>	<u>FORMATION TOPS</u>	
Surface Soil	35	Heebner	3220 -1279
Sand and Gravel	200	Brown Lime	3325 -1384
Blue Shale	295	Lansing	3335 -1394
Sand	410	Base of Kansas City	3562 -1621
Red Bed	575	Viola	3572 -1631
Shale	857	Simpson	3594 -1653
Anhydrite	880	Arbuckle	3656 -1714
Shale and Shells	1095	Rotary Total Depth	3670 -1729
Red Bed and Shale	1495		
Shale and Lime	1669		
Lime and Shale	3030		
Lime	3150		
Lime and Shale, Chert	3200		
Lime and Shale	3530		
Lime	3572		
Cherty Lime	3590		
Cherty Lime and Shale	3620		
Shale and Lime	3660		
Dolomite	3670		

RECEIVED
STATE CORPORATION COMMISSION

MAR 26 1963

CONSERVATION DIVISION
Wichita, Kansas

We hereby certify the foregoing to be a true and correct copy of the Driller's Log of the test drilled in the NW SW NW of Section 9, Township 21 South, Range 14 West, Stafford County, Kansas.

QUAKER DRILLING CO., INC.

By: Thomas M. McCaul
Thomas M. McCaul, President

SUBSCRIBED AND SWORN to before me a Notary Public this 25th day of February, 1963:

Virginia Mundell
Virginia Mundell, Notary Public

MY COMMISSION EXPIRES:
August 10, 1965